

RESOLUTION	APPENDIX C FLATHEAD COUNTY ZONING REGULATION AMENDMENTS	ADOPTED
955C (zoning maps only)	Because B-1 and B-2 were previously consolidated, this amendment renamed B-4 to B-3, and B-3 to B-2.	4/21/94
955E	Amending Various Sections.	6/2/94
955G	Section 5.08.020(3)(A) amended to state, “Lots within the cluster subdivision may not exceed a net average of two (2) acres. Section 5.08.020(3)(D) amended to change open space requirements. Section 5.08.020(6) amended by replacing the Density Bonus Allowance Chart.	7/18/94
955I	Amend Section 3.13.030(12) to allow campgrounds/RV parks as a conditional use in R-5 (Two Family Residential)	7/25/94
955K	Add Section 3.32 adding an overlay SC (Scenic Corridor) Zoning Classification.	2/6/95
955M	Amend Various Sections.	7/25/95
955O	Amend Sections: 2.08.020(9) & 2.08.030(1)(E) – protests against amendments to zoning regulations so as to comply with 1995 legislative changes, Amend Section 5.10.020(10) re: Manual Changeable Copy, Section 3.18.020 deleting 20. Pet Shops, Sections: 3.17.030, 3.18.030, 3.27.030, 3.28.030 & 3.29.030 adding use: caretaker’s facility, Add Section 4.07, Contractors Storage Yards.	1/16/96
955Q	Add Section 3.33 (LBL) Little Bitterroot Lake Classification.	2/27/96
955S	Amend Sections: 3.04.040.3, 3.05.040.3, 3.06.040.3, 3.07.040.3, 3.08.040.3, 3.09.040.3 & 2.07.040, Reduce side yard setback requirements for existing lots, which are below the minimum lot width.	4/30/96
955U	Amend Sections: 7.13.010(1) & 7.13.010(2) – delete “on a permanent foundation” & amend Section 7.13.010(1)(E) – manufactured home standards & Add Section 7.07 – definition “Foundation, properly engineered”.	6/3/96
955W	Amend Section: 3.14.030 allowing “Motor Coach Subd” as conditional use in RC-1 zoning districts; add new Sec. 4.14 conditional use standards for Motor Coach Subd., and adding definition in Sec. 7.13.	8/1/96
955Y	Amend Sections: 3.09.040.4, 3.10.040.4, 3.12.040.4, 3.13.040.4, - Building Heights to allow accessory buildings to be as high as primary buildings. Amend Sections: 3.07.040.2, 3.08.040.2 reducing lot widths in SAG-10 & SAG-5 & Sections: 7.13.010.1.B & 7.13.010.A – defining manufactured homes width. <i>Administrative clarification, 11/03/11: The above summary of Resolution No. 955Y added to the regulations at that time inaccurately describes its effect on accessory building heights in residential zones, which is clarified as follows: Resolution 955Y amended Section 3.09.040.4 to allow a tiered increase in accessory building height in R-1 zones dependent on the setback distance; and amended Sections 3.10.040.4, 3.11.040.4, 3.12.040.4 and 3.13.040.4 to increase accessory building height in R-2, R-3, R-4 and R-5 zones from 15 to 18 feet.</i>	12/19/96

RESOLUTION	FLATHEAD COUNTY ZONING REGULATION AMENDMENTS <i>(Continued...)</i>	ADOPTED
955AA	Add Section 3.34 West Valley Zoning District.	4/9/97
955AC	Amend Section 3.17.020 Add theaters housed in permanent indoor structures to list of permitted uses in B-2 (General Business).	4/28/97
955AE	Add Section 3.36 (HD) Hubbard Dam Zoning Classification.	5/5/97
955AG	Add Section 3.37 (RL) Rogers Lake Zoning Classification.	5/27/97
955AI	Amend Sections: 7.15.030, 7.23.010, & 5.08.040, Open Space Text Amendments redefining permitted uses of open space.	9/22/97
955AK	Amend Section 3.27.202 – clarify and expand permitted uses in I-1 (Light Industrial) zoning districts.	11/4/97
955AM	Add Section 3.38 (AL) Ashley Lake Zoning Classification.	12/8/97
955AP	Amend Section 3.18.030 – add duplex dwellings, multi-family dwellings, dwellings in mixed-use buildings and resort dwellings as conditional uses in B-3 zoning districts.	2/18/98
955AR	Amend Section 3.26.020 add single-family, duplex, multi-family and dwellings in mixed-use buildings as permitted uses in CVR zoning district, amend Section 5.01.030, 5.09 and 7.17 to define and clarify the provisions regarding retaining walls.	7/23/98
955AT	Amend Section 5.07 Lots (Flag Lots).	8/24/98
955AV	Amend Section 3.33.060 Special lakefront lot open space development standards (LBL).	9/8/98
955AX	Add Section 3.39 (LL) LaBrant/Lindsey Lane Zoning Classification.	10/5/98
955AZ	Add Section 3.40 (NF) North Fork Zoning Classification.	10/26/98
955BB	Amend Little Bitterroot Lake Zoning Classification.	1/27/99
955BD	Amend Sections 3.20.015, 3.20.020, 3.20.030, and 3.20.040 and delete Section 3.20.050.	2/2/99
955BH	Amend Section 3.13.040(5) R-5, Two Family Residential, increase permitted lot coverage.	3/29/99
955BF	Add new section 2.06.45 Administrative Conditional Use Permit Procedure.	5/25/99
955BJ	Amend 7.04.120 definition of Community Residential Facility, Add Section 5.03, Community Residential Facilities, delete various sections as a result of text amendment and renumber.	5/25/99
955BL	Amend Section 5.11.030, Billboard Signs Requiring a Permit.	11/15/99

RESOLUTION	FLATHEAD COUNTY ZONING REGULATION AMENDMENTS <i>(Continued...)</i>	ADOPTED
955BN	Add subsection 10 to Section 5.11.010, Residential Subdivision Signs.	11/15/99
955BR	Amend Ashley Lake Zoning District Regulations, Section 3.38, to clarify the use of Recreation Vehicles.	01/03/00
955BT	Amend Sections 3.27 & 3.28, allowable and conditional uses in I-1 and I-1H districts.	01/03/00
955BV	Amend Section 2.07.040; remove additional 20' required along state & federal roadways in various zoning districts.	01/03/00
955BP	Add Marina definition, add sections 3.31.030(3)(D) Marina PUD Districts and Section 3.31.030(4)(D) Marina PUD District Use Regulations.	01/18/00
955BX	Add Section 3.41, Creating Airport Overlay Zoning District.	01/27/00
955BZ	Amend Section 3.34.030, allowing Class 3 Landfills as a conditional use.	01/27/00
955CB	Amend Section 3.28.050(3)(B) to allow an exemption from landscape requirements in the I-1H zoning district.	01/27/00
955CD	Add Section 3.42, Lakeside Zoning District Classifications, Amend Section 3.31 to include the Lakeside Zone in which a marina PUD may be proposed.	02/24/00
955CF	Add Section 3.33.120 to Little Bitterroot Lake Zoning Classification to allow for temporary recreational vehicle parking and camping.	03/29/00
955CH	Amend Sections 3.04.030(10), 3.05.030(10), 3.06.030(10), 3.07.030(9), 3.08.030(9), 3.09.030(8), 3.10.030(4), 3.11.030(3), 3.12.030(4), 3.13.030(4), 3.14.030(3), & 3.15.030(6) to clarify Community Center building use and add Section 7.04.115 defining Community Center Buildings.	06/15/00
955CJ	Amend numerous sections to include Cellular Towers as permitted and conditional uses and add new Section 5.13, containing Performance Standards for cellular communication towers.	06/15/00
955CL	Amend Section 3.27.020 to add new/used automobile, recreational vehicle, utility trailer, and watercraft sales to I-1 Light Industrial.	09/18/00
955CO	Amend Sections 3.16 by adding branch bank operations to B-1 Neighborhood/Professional Business.	11/16/00
955CQ	Amend Section 3.33.050(5) to change the maximum height of buildings in the Little Bitterroot Lake (LBL) Classification from 30 feet to 35 feet.	11/28/00
955CS	Amend Sections 3.38.020, 3.38.030, and 3.38.065 to clarify the standards for placement of recreational vehicles on a temporary basis in the Ashley Lake Zoning District.	01/9/01

RESOLUTION	FLATHEAD COUNTY ZONING REGULATION AMENDMENTS <i>(Continued...)</i>	ADOPTED
955CU	Amend Sections 3.27.020 and 3.28.020 to include high tech industrial business in I-1 and I-1H and amend Chapter VII to add a definition for high tech industrial business.	04/18/01
955CW	Amend Section 3.37.050 to change height restriction in Rogers Lake Zoning Classification from 30 feet to 35 feet.	04/18/01
955CY	Amend Section 3.38.050 to change height restriction in Ashley Lake Zoning Classification from 30 feet to 35 feet.	04/18/01
955DA	Amend Sections 3.38.020 & 3.38.030 to allow Class A & Class B manufactured homes & allow use of two recreational vehicles on an undeveloped tract of land after issuance of an Administrative Conditional Use Permit.	04/18/01
955DC	Add Section 3.17.20 Permitted Uses (B-2) Day care Centers and add Section 3.18.20 Permitted Uses (B-3) Day care centers.	06/26/01
955DE	Remove references to Countywide Administrative Board and Flathead Regional Development Office and replace them with Flathead County Board of Commissioners and Flathead County Planning & Zoning Office.	07/26/01
955DG	Add Section 5.11.020(11)(D) to require that allowed sign area is calculated by measuring only one face of multiple-faced signs.	07/26/01
955DI	Add new Section 3.32.010(2) to allow cellular towers as a permitted use in the Scenic Corridor Zoning Classification, delete Section 3.32.030 under which cellular towers are a conditional use in the Scenic Corridor Zoning Classification, and add Section 5.13.115 setting forth performance standards for cellular towers.	07/26/01
955DK <i>Reaffirmed</i> 955EU	Amend Sections 3.04.040.3, 3.05.040.3, 3.06.040.3, 3.07.040.3, and 3.08.040.3 to decrease the side corner setbacks in the AG-80, AG-40, AG-20, SAG-10 and SAG-5 agricultural zones from 20 feet to 15 feet for nonconforming lots with average widths of less than 200 feet.	12/18/01 08/18/03
955DM <i>Reaffirmed</i> 955FM	Amend Section 3.31.030(4) to allow for an expanded percentage of commercial use in residential or mixed-use Planned Unit Developments.	02/11/02 09/30/03
955DO <i>Reaffirmed</i> 955EO	Amend Section 5.09.020 to allow for additional development opportunities for properties that utilize the Cluster Development provisions in the AG (Agricultural) and SAG (Suburban Agricultural) zoning classifications.	02/11/02 08/12/03
955DQ <i>Reaffirmed</i> 955EM	Amend Section 3.08.030(24) to allow rodeo arenas as a conditional use in SAG-5 zoning districts.	02/11/02 08/12/03
955DS <i>Reaffirmed</i> 955FK	Amend Sections 3.27.020, 3.27.030, 3.28.010, 3.28.020, 3.28.030, 3.29.010, 3.29.020, and 3.29.030, and delete Section 3.28.060 to allow for many commercial and residential uses, as permitted or conditional uses, in all of the industrial zoning districts, i.e., I-1(Light Industrial), I-1H (Light Industrial – Highway), and I-2 (Heavy Industrial).	03/05/02 08/25/03

RESOLUTION	FLATHEAD COUNTY ZONING REGULATION AMENDMENTS <i>(Continued...)</i>	ADOPTED
955DU <i>Reaffirmed</i> 955FC	Amend Section 2.07.040(4) to remove the 50% restriction on expansion of non-conforming uses and to allow for expansion of nonconforming uses within the confines of the parcel of land.	04/08/02 08/19/03
955DW <i>Reaffirmed</i> 955FA	Amend Section 3.31.030(3)(A) by adding the Lakeside (LS) District to the Residential PUD Districts and Section 3.31.030(4)(A) by adding the Lakeside (LS) District to the Residential PUD District Density @ 15 dwelling units/acre.	04/8/02 08/19/03
955DY <i>Reaffirmed</i> 955FG	Amend Section 3.42.020 & 3.42.030 to allow public schools as a permitted use and private schools as a conditional use in the Lakeside Zoning Classification. Amend Section 7.18 by adding Section 7.18.15 – definition of public schools.	06/13/02 08/19/03
955EA <i>Reaffirmed</i> 955EY	Amend Section 7.08.050 to allow for kitchens in guest houses and deleting the requirement that guest houses be used for sleeping quarters only.	07/02/02 08/19/03
955EC <i>Reaffirmed</i> 955EW	Amend Section 5.11.040 to allow more signage to advertise permitted and conditional use businesses in B-1 (Neighborhood/Professional Business) zoning districts.	09/03/02 08/18/03
955EG <i>Reaffirmed</i> 955ES	Amend Sections 3.09.040, 3.10.040, 3.11.040, 3.12.040, 3.13.040, 3.14.040, and 3.15.040 to increase the maximum fence height for front yards in residential zones (R-1, R-2, R-3, R-4, R-5, RC-1 and RA-1) from 3 feet to 4 feet.	11/27/02 08/18/03
955EI <i>Reaffirmed</i> 955EQ	Amend Section 5.11.010(10) to apply sign requirements for subdivision signs to all subdivisions, including commercial and industrial subdivisions, rather than only residential subdivisions, and allow “earth tone” background colors rather than only “brown” backgrounds.	12/30/02 08/18/03
955EK <i>Reaffirmed</i> 955FE	Amend Section 7.03.100 Definition of Building Line to allow eaves on buildings to encroach up to two feet into setbacks required in the zoning districts.	03/06/03 08/19/03
955FI	Amend Sections 3.12.030, 3.13.030, and 3.15.030 to add Beauty Salons and Barbershops as a conditional use in R-4, R-5 and RA-1 zones.	09/02/03
955FQ	Amend Sections 3.05.020 & 3.06.020 by adding Kennels as a permitted use in AG-40 and AG-20 zones.	12/08/03
955FS	Amend Section 5.11.040(4)(D) and 5.11.040(5)(D) to correct a typographical error to refer to Section 5.11.020(11) rather than Section 5.10.020(11).	12/08/03
955FO	Amend North Fork Zoning Regulations – Section 3.40 by adding Permitted & Conditional Uses – Sections 3.40.020 & 3.40.030; and Add Section 3.40.050 Definitions.	12/24/03

RESOLUTION	FLATHEAD COUNTY ZONING REGULATION AMENDMENTS (Continued...)	ADOPTED
955FY	Amend Sections 4.10.010 & 4.10.040 of the Flathead County Zoning Regulations to recognize that the Montana Open Cut Mining Act, due to a statutory change, is now administered by the Montana Department of Environmental Quality rather than the Montana Department of Natural Resources.	05/04/04
955GA	Amend Sections 3.07.040(2) and 3.08.040(2) in the SAG-10 and SAG-5 (respectively) classifications, to allow for lot depth to exceed lot width by more than three times if the average lot width is at least 300 feet (changed from 330 feet).	04/21/04
955GE	Amend Sections 3.12.040.2, 3.13.040.2, & 3.15.040.2 in the R-4, R-5, RA-1 classifications to allow for sub lot minimum width to be 25-feet rather than the 50-foot minimum lot width in order to allow for building of townhouses in the urban density zoning classifications.	07/12/04
955GG	Amend Section 4.13.040 to change the height limitation for mini-storage facilities from one story (18-ft at peak) to two stories (35-ft at peak).	07/22/04
955GM	Added new subsections 9 and 10 to Section 3.03.020 to define those zoning districts that allow residential uses as residential ones for purposes of Section 76-2-209, M.C.A., to delete Section 3.09.030(14) in order to delete extractive industries as a condition use in R-1 zones, and to amend Section 3.07.010 to allow for estate-type residential development in SAG-10 zoning districts, in order that regulation of operations that mine sand and gravel or that mix concrete or batch asphalt may be allowed, conditioned or prohibited in those residential zones.	08/17/05
955GK	Amend Section 3.30.030 by adding Sewage treatment plans as item 18 in the list of Conditional Uses for Public Zoning Districts.	12/14/05
955GO	Amend Section 3.17.020 (B-2, General Business) by adding #34 to include the following uses: Repair of equipment and consumer items such as appliances, clocks and watches, lawn and garden equipment, computers, televisions, shoes, and furniture in an enclosed facility.	12/14/05
955GS	Amend Sections 3.04.040, 3.05.040, 3.06.040, 3.07.040, and 3.08.040 to clarify that residential clustering setbacks for AG and SAG districts found in the performance standards are different from setbacks set forth in the AG and SAG districts where clustering is not employed.	03/04/08
955GU	Amend Section 3.03.020 of the Flathead County Zoning Regulations to redefine what districts are “residential” for purposes of applying the zoning regulations to gravel operations, and clarify that AG-40 (Agricultural) and AG-80 (Agricultural) districts are not residential zones for those purposes and (ii) amend Section 4.10.010 of the Flathead County Zoning Regulations to remove the requirement that a Montana Department of Environmental Quality reclamation contract be executed prior to the issuance of a conditional use permit for gravel operations.	03/20/08

RESOLUTION	FLATHEAD COUNTY ZONING REGULATION AMENDMENTS (Continued...)	ADOPTED
955GW	Amend Section 1.04.020 of the Flathead County Zoning Regulations to state as follows: The growth policy and neighborhood plans are not regulatory and do not confer any authority to regulate. The growth policy and neighborhood plans are intended to provide direction and guidance when consideration is given to adopting, amending, and interpreting zoning regulations.	10/09/08
955GY	Amend Section 4.10.040 of the Flathead County Zoning Regulations, setting forth the process by which conditional use permits for gravel permits are issued, by deleting the sentence thereof which requires that “When such a plan is also required by the Open Cut Mining Act, the submitted plan shall have been approved by the Department of Environmental Quality” and replacing it with a sentence that states that “When such a plan is also required by the Open Cut Mining Act, the submitted plan must include all information required by the Department of Environmental Quality for such an application.”	10/09/08
955HA	Add Section 3.43 to the Regulations which would define a new zoning classification denominated R-2.5 (Rural Residential) intended for rural, primarily residential areas where larger, estate-type lot sizes are appropriate and where agricultural, silvicultural and horticultural operations are a decreasingly viable land use, and by amending other sections of the Flathead County Zoning Regulations to make references to the new classification where appropriate.	12/08/08
955HC	Section 2.08.020(4) amended to read: Applications shall be reviewed under the regulations in place on the date a complete application is submitted to the Zoning Administrator. Section 3.03.030 to read: In the interpretation of Sections 3.04 through 3.43. Sections 3.31.030(4)(A), 4.03.030, and 7.04.120, are amended by adding a reference to the R- 2.5 classification. Section 3.30.020 is amended by adding the following subsections: 13. Fire Stations and 14. Police Stations. Section 7.07 is amended by adding the following subsection: 7.07.055. Section 7.16 is amended by adding the following subsection: 7.16.075. Section 3.03.020(3) is amended to replace the word “primary” with “principal.” Section 7.18.045 is amended by adding front, side, side corner, and rear setback subsections. Section 7.19 is amended by adding the following subsection: 7.19.005. Section 2.08.020(7) is amended in regard to public hearing notice, pursuant to changes to statute made in the 2009 legislative session. Section 2.08.040 is amended regarding zoning amendment criteria, pursuant to changes to statute made in the 2009 legislative session.	01/04/10
955HE	Add Section 7.08.025 to the definitions chapter of the regulations to define “Gravel Extraction” to include mining of gravel and, <i>inter alia</i> , the processing of gravel through crushing, screening, asphalt, wash and concrete plants, and transportation and stockpiling of materials on gravel mining sites.	03/01/10

RESOLUTION	FLATHEAD COUNTY ZONING REGULATION AMENDMENTS (Continued...)	ADOPTED
Correction of Administrative Error	On July 12, 2004 the Commissioners approved Resolution 955GE amending the R-4, R-5 and RA-1 zones to allow 25' minimum lot widths for sub lots <i>in addition to</i> the 50' minimum lot width for standard lots. At that time, the planning office erroneously <i>replaced</i> the 50' minimum lot width with a 25' minimum lot width in the text of the zoning regulations. This error was discovered in October of 2010 and the regulations were corrected to accurately reflect the text amendment which was originally approved in 2004.	10/13/10
955HG	Add Section 3.34.030 "Community residential facilities" as a conditional use under the West Valley zoning designation with facilities serving eight or fewer residents eligible for an administrative conditional use permit (defined as Class I facilities according to Section 7.04.120 of the zoning regulations).	11/08/10
955HJ	Amend Section 3.14.030 Conditional Uses under SECTION 3.14 RC-1 RESIDENTIAL CLUSTER replacing #14 "Real estate office" with "Professional Offices".	05/23/11
955HL	Add Section 3.44 to the regulations creating the "B-2HG General Business Highway Greenbelt" zone. Also amend references throughout regulations so existing references to the B-2 zone add the B-2HG zone.	07/27/11
955HN	Various amendments to improve administration of the regulations, including: 1) Eliminate plural endings for words in descriptions of permitted and conditional uses throughout the regulations which erroneously imply that multiple instances of a use are permitted on a single tract of record. 2) Delete the second paragraph of § 3.38.160, which refers to the Ashley Lake Neighborhood Plan for regulatory authority. 3) Add a sentence to § 5.07.010 to clarify that there is no restriction on the number of livestock animals in agricultural zoning districts. 4) Delete the first sentence of § 5.05.030 which removes the one year time-frame to meet 'greenbelt' landscaping requirements.	05/08/12
Correction of Administrative Error	On February 24, 2000 the Flathead County Commissioners approved Resolution #955CD adding a Lakeside (LS) zoning classification to the Flathead County Zoning Regulations. When the LS zoning classification was then codified inserted into the Flathead County Zoning Regulations, it was done so erroneously. The error was discovered on August 07, 2012 during the processing of a Conditional Use Permit. The regulations were administratively amended to reflect the correct codification of the LS zoning classification as it appeared attached to Resolution 955CD.	08/15/12
955HP	Various amendments to improve administration of the regulations, including: 1) Amend § 3.40.030 to add 'Cellular tower' to the list of conditional uses as an administrative conditional use. 2) Amend § 3.04.020, § 3.05.020, § 3.06.020, § 3.07.020, and § 3.08.020 to add 'Livestock' to the list of permitted uses in AG-80, AG-40, AG-20, SAG-10 and SAG-5. 3) Amend § 3.04.020, § 3.05.020, § 3.06.020 and § 3.07.020 by removing Stable from 'Stable, riding academy rodeo arena' and add 'Stable, public and private' to the list of permitted uses in AG-80, AG-40, AG-20 and SAG-10. 4) Amend § 3.08.020 and § 3.08.030 by adding 'Stable, private' to the list of permitted uses in SAG-5 and replacing 'Stable, riding academy rodeo arena' with 'Stable, public' and 'Riding	06/10/14

RESOLUTION	FLATHEAD COUNTY ZONING REGULATION AMENDMENTS (Continued...)	ADOPTED
	academy, rodeo arena’ on the list of conditional uses in SAG-5. 5) Remove restrictions on timing of posting of political signs on all private property in § 5.11.010(8). 6) Amend § 6.16.010 by replacing ‘Approach Standards for Montana Highways’ with ‘Montana Department of Transportation or Flathead County Road and Bridge Department’ and replace the word ‘greater’ with ‘more stringent.’ 7) Amend § 1.02.010, § 2.02.040, § 3.01.010, § 3.31.030(3)(A) and § 3.39.110(2) by replacing ‘Master Plan’ with ‘Growth Policy.’ 8) Amend § 4.04.010 and § 7.04.025 by replacing ‘principal dwelling’ with ‘principal use.’ 9) Amend § 4.04.010(4) to strike all references to deed restrictions. 10) Amend § 5.09.030(7) by replacing ‘at least 40 feet from any other boundary of the “parent” tract or adjacent property(ies);’ with ‘otherwise conform to the minimum setbacks of the district;’ and amend § 3.04.040(3), § 3.05.040(3), § 3.06.040(3), § 3.07.040(3), § 3.08.040(3) by removing reference to clustering setbacks.	
Correction of Administrative Error	On June 10, 2014 the Flathead County Commissioners approved Resolution #955HP amending § 3.04.040(3), § 3.05.040(3), § 3.06.040(3), § 3.07.040(3), § 3.08.040(3) by removing reference to clustering setbacks. When § 3.04.040(3), § 3.05.040(3), § 3.06.040(3), § 3.07.040(3), § 3.08.040(3) were then codified and inserted into the Flathead County Zoning Regulations, it was done so erroneously as ‘***’ remained after the reference was removed. This error was discovered in August of 2014 and the regulations were corrected to accurately reflect the text amendment which was originally approved in June of 2014.	08/21/14
955HR	Amend § 3.04.020, § 3.05.020, § 3.06.020, § 3.07.020, § 3.08.020, § 3.09.020, and § 3.43.020 to add ‘Dwelling unit, accessory (ADU).’ to the list of permitted uses. Amend § 3.10.030, § 3.11.030, § 3.12.030, § 3.13.030 and § 3.15.030 to add ‘Dwelling unit, accessory (ADU).’ to the list of conditional uses. Add ‘Dwelling unit, accessory (ADU).’ to § 5.01.020(1) and add ‘Dwelling unit, accessory (ADU) requires Administrative Conditional Use Permit.’ to § 5.01.020(3). Amend § 5.01.030(7) to read ‘Guest houses, caretakers facilities, and accessory dwelling units (ADU) are subject to the same setback requirements as the principal structure.’ Add § 6.02.060 to the residential parking requirements. Add § 7.05.150 to the definitions chapter of the regulations to define ‘Dwelling unit, accessory (ADU).’	01/21/15
955HT	Amend § 5.06.020(1)(e) to increase vehicle traffic allowed for a home occupation from 8 all day to 16 vehicle trips all day and remove restriction of 1 at a given time. Amend § 5.06.020(2)(c) to allow between 16 and 32 vehicle trips all day with a conditional use permit. Amend § to remove language from the definition of home occupation. Add § 7.19.045 definition of trips.	05/12/15
955HV	Add Section 3.45, creating Evergreen Enterprise Overlay Zoning District.	02/24/16
Correction of Administrative Error	Amended Section 5.11.010 (10), an error was discovered in March of 2016 under on premise exempt signs size. The correction added the word “square” to read 60 square feet.	03/29/16

RESOLUTION	FLATHEAD COUNTY ZONING REGULATION AMENDMENTS <i>(Continued...)</i>	ADOPTED
2416 A	Add Sections 3.46, 3.47, 3.48, 3.49 and 3.50, creating the B-2A Secondary Business District, BMRR Big Mountain Resort Residential, BMV Big Mountain Village, BSD Business Service District and RR-1 Low Density Resort Residential.	04/07/16
Correction of Administrative Error	Amended Sections 3.04.040(3)(b), 3.05.040(3)(b), 3.06.040(3)(b), 3.047.040(3)(b), and 3.08.040(3)(b), an asterisk was removed after the side setback requirement for a detached accessory structure which required a 10 foot setback for a lot with widths between 50 feet and 150 feet and 5 feet for all other lots.	05/04/16
1323C	Amended Section 3.39.020 to remove family hardship dwelling from the list of permitted uses; amend section 3.39.030 to add dwelling unit, accessory (ADU) and dwelling, family hardship to the list of conditional uses; amend Section 3.39.040 to add setbacks to conditions deemed to have “grandfather” rights and to add setbacks from all property lines; amend Section 3.39.120 to add definitions for bed and breakfast, caretaker’s facility, dwelling unit, accessory ADU, dwelling, family hardship, and to modify to definition of guest house.	03/08/17
955HX	Amend Sections 3.04, 3.05, 3.06, 3.07, 3.08, 3.09, 3.10, 3.11, 3.12, 3.13, 3.14, 3.15, 3.33, 3.34, 3.37, 3.38, 3.39, 3.42, and 3.43 to add short term rental housing to the list of conditional uses that require administrative conditional use approval. Add Section 4.16 Short Term Rental Housing outlining the minimum conditional use standards for short term rental housing.	08/07/17
955HZ	Add Section 3.51, creating the SWO Highway 93 South Whitefish Overlay.	11/29/17
955IB	Amend various sections, rearranged order of use districts, eliminated use districts, added and deleted definitions.	3/19/19
Correction of Administrative Error	Amended Section 3.25.040(2) and 3.26.040(1), an error was discovered in October of 2019 under Minimum Lot Area. The correction added the word “additional” and “in excessive of one” to read 2,000 square feet for each additional dwelling unit in excessive of one.	10/1/19
955ID	Amend Sections 3.08.040, 3.30.030(11), 3.31.030(10), 3.42.020(14) and (24), and 8.05.160. Remove Sections 3.35.130, 3.35.150, 3.42.030(14), 4.04(1), 4.05.010(7)(C), and (D).	1/14/20
955IF	A complete rewrite of Section 3.34 SC-Scenic Corridor and Section 3.45 PUD-Planned Unit Development, removing the definitions of apartment house, building area or footprint, mean ground level, rooming house, and solid planting, adding a definition of off-premise sign, and moving commercial caretaker’s facility in a detached accessory building in conjunction with a business from a conditional use in Section 3.19.030 to a permitted use in Section 3.19.020 in the B-2 General Business Zone.	8/11/20
955IH	Text amendment to Sections 3.20.030 and 8.17.020 to add ‘Marina’ as a Conditional Use Permit to B-3 zone and to the definition of ‘Recreational Area, Commercial.’	11/2/21
9551K	Text amendment to Section 2.08	4/19/22
955IN	Amend Section 5.11 Short-Term Rental Housing to add and amend the minimum conditional use standards for short-term rental housing.	08/31/23

SEARCH

Owner

Search by Owner Name



Geocode

Search by Geocode (ParcelID)



Address

Search by Property Address



Subdivision

Search by Subdivision



Assessment Code

Search by Assessment Code



Certificate

Search by Certificate of Survey



PROPERTY INFORMATION

Property 386 SCHOOL ADDITION RD

Address: SOMERS, MT 59932

Geocode: 07-3834-23-4-02-01-0000

Tax Year: 2025


Summary



Primary Information

Property Category: RP

Subcategory: Residential Property

Geocode: 07-3834-23-4-02-01-0000

Assessment Code: 0000974601

Primary Owner:

VISTAS OVER SOMERS LLC
6800 DEERPATH RD STE 100
ELKRIDGE, MD 21075-6253

Property Address:

386 SCHOOL ADDITION RD
SOMERS, MT 59932

Note: See Owners section for all owners
Certificate of Survey: 2838 **Legal Description:** S23, T27 N, R21 W, ACRES 9.37, TR 7EDB IN NW4SE4 (W/TR 7EX FKA TR 7H)

Last Modified: 1/18/2025 12:55:47 PM

General Property Information

Neighborhood: 207.800.0 **Property Type:** Vacant Land

Living Units: 0

Levy District: 07-032702-29 - FS

Zoning:
Ownership: 100%

LinkedProperty:


Discover DEQ Map



2/14/2025, 1:58:54 PM

Montana Petroleum Releases



Resolved



Montana State Superfund Unit Facilities



Montana Federal Superfund Project Boundaries



Montana County Boundaries

1:9,028

0 0.05 0.1 0.2 mi

0 0.07 0.15 0.3 km

Montana State Library, Esri Community Maps Contributors, Montana State Library, © OpenStreetMap, Microsoft, Esri, TomTom, Garmin, SafeGraph,

Montana DEQ


This map is provided "as-is" without warranty of any kind. Montana DEQ makes no representations or warranties whatsoever with respect to the accuracy or completeness of this data set and assumes no responsibility for any damages incurred as a result of errors in

Plate 2b
Quaternary Faults in Western Montana


MBMG Publication XXX
Probabilistic Earthquake
Ground Shaking Maps for the
State of Montana

by
Ivan Wong, Susan Olig, Mark Dober,
Douglas Wright, Eliza Nemser, David Lageson,
Walter Silva, Michael Stickney, Michele Lemieux
and Larry Anderson


2005

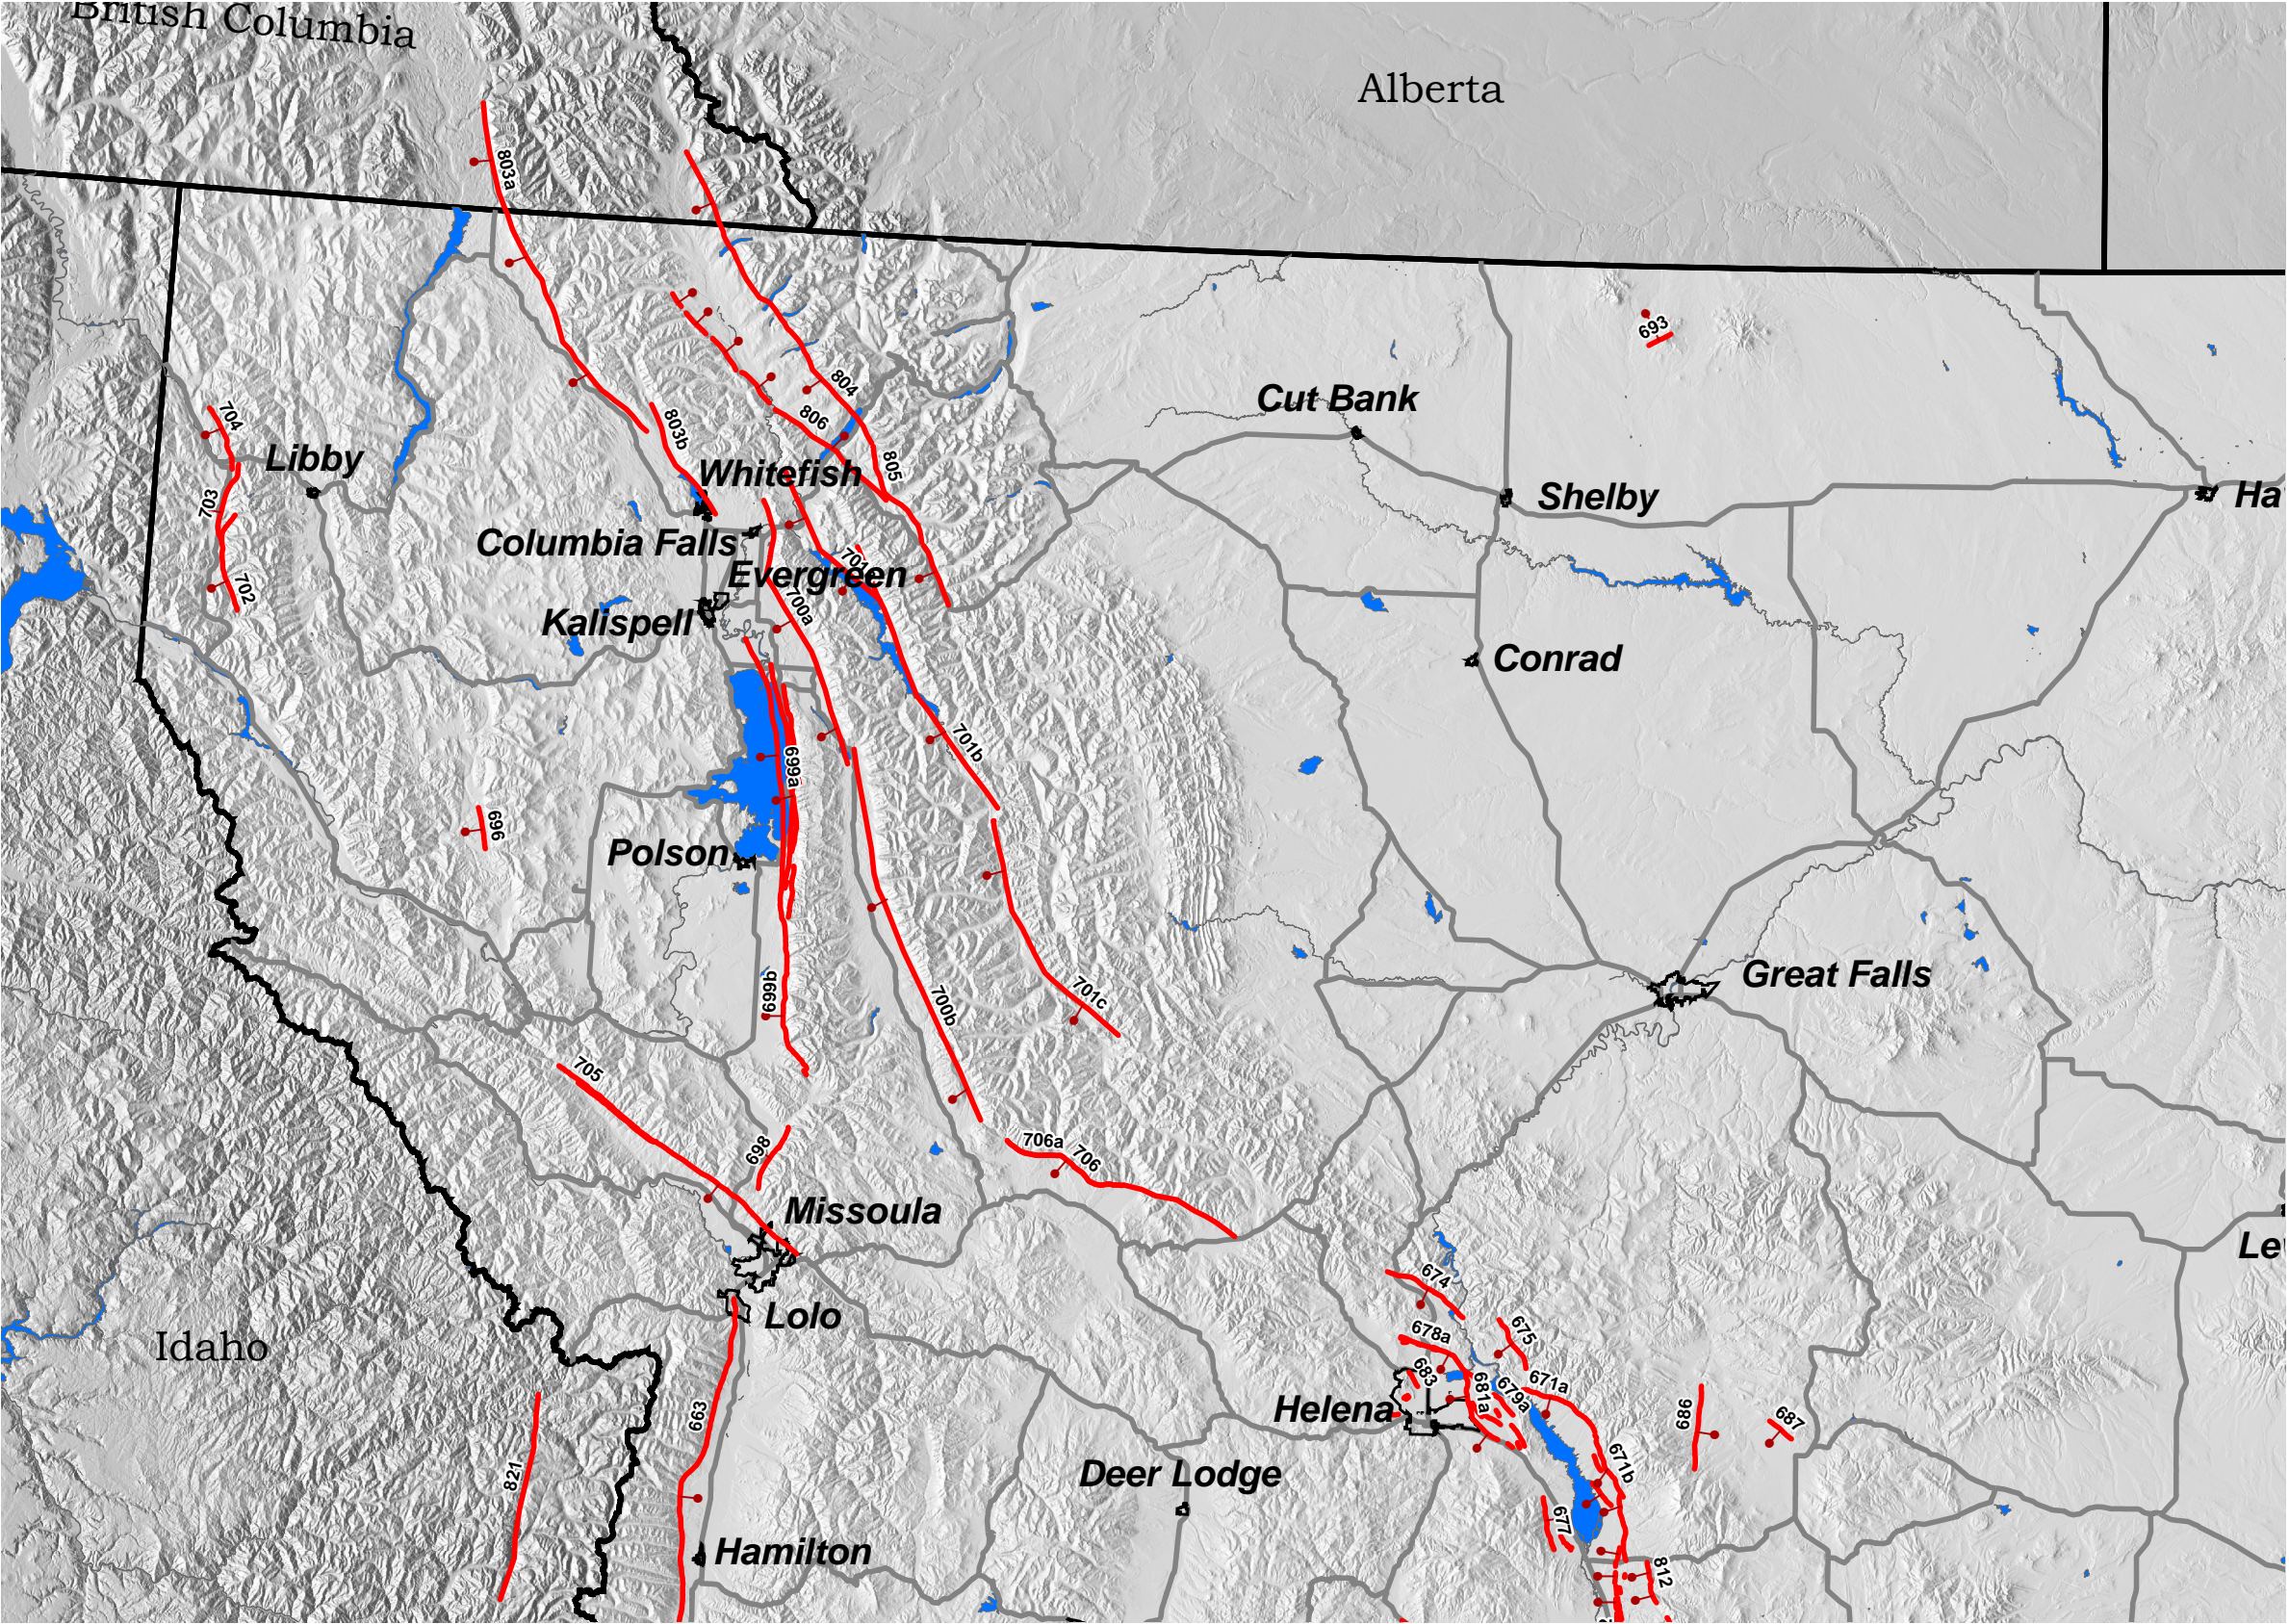

Quaternary Faults
Fault Database modified from Stickney and others, 2000
(See Appendix for other fault map sources)

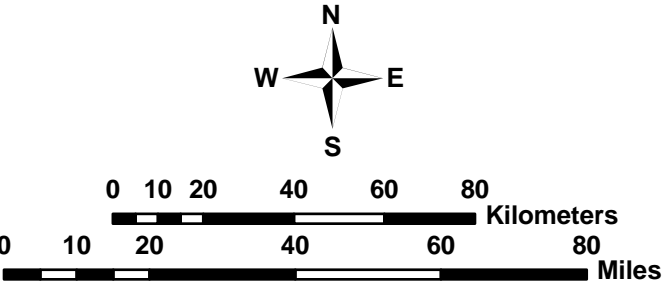

Map Index

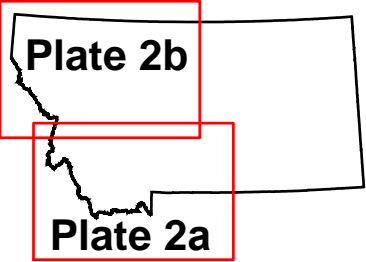

Project supported by the Montana Department of Natural Resources and Conservation and the Federal Emergency Management Agency. Basemap data from Montana State Library, Natural Resource Information System, GIS and layout by URS Corporation. Published by Montana Bureau of Mines and Geology.

Lakeside-Somers CCD, Flathead County, Montana

Lakeside-Somers CCD, Flathead County, Montana is a city, town, place equivalent, and township located in [Flathead County, Montana](#). Lakeside-Somers CCD, Flathead County, Montana has a land area of 94.8 square miles.

// [United States](#) / [Montana](#) / [Flathead County, Montana](#) / Lakeside-Somers CCD, Flathead County, Montana

☐ Display Sources

Populations and People

Total Population
6,185
P1 | 2020 Decennial Census

Education

Bachelor's Degree or Higher
36.0%
S1501 | 2023 American Community Survey 5-Year Estimates

Housing

Total Housing Units
2,962
H1 | 2020 Decennial Census

Families and Living Arrangements

Total Households
2,552
DP02 | 2023 American Community Survey 5-Year Estimates

Income and Poverty

Median Household Income
\$72,500
S1901 | 2023 American Community Survey 5-Year Estimates

Employment

Employment Rate
57.4%
DP03 | 2023 American Community Survey 5-Year Estimates


Health

Without Health Care Coverage
4.0%
S2701 | 2023 American Community Survey 5-Year Estimates

Race and Ethnicity

Hispanic or Latino (of any race)
178
P9 | 2020 Decennial Census

Lakeside-Somers CCD, Flathead County, Montana Reference Map

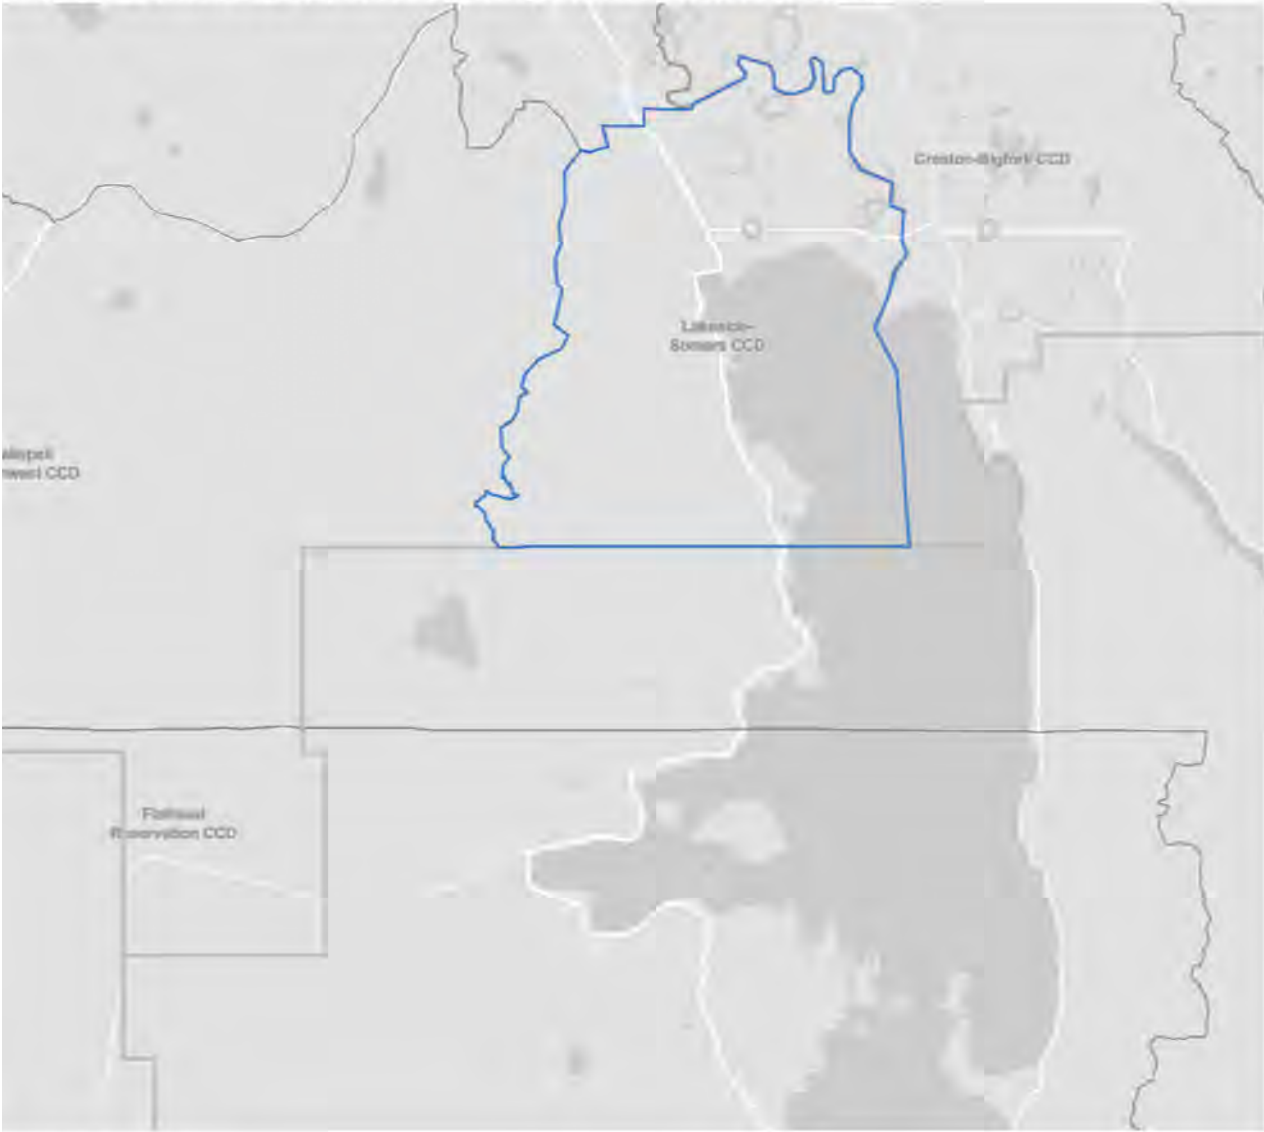

Populations and People



Appendix B: Soil Survey

114° 14' 40" W



12/3/2024
Page 1 of 5

MAP LEGEND

Area of Interest (AOI)

 Area of Interest (AOI)

Soils

Soil Rating Polygons

 A
 A/D
 B
 B/D
 C
 C/D
 D
 Not rated or not available

Soil Rating Lines

 A
 A/D
 B
 B/D
 C
 C/D
 D
 Not rated or not available

Soil Rating Points

 A
 A/D
 B
 B/D

 C
 C/D
 D
 Not rated or not available


Water Features

 Streams and Canals

Transportation

 Rails
 Interstate Highways
 US Routes
 Major Roads
 Local Roads

Background

 Aerial Photography

MAP INFORMATION

The soil surveys that comprise your AOI were mapped at scales ranging from 1:20,000 to 1:24,000.

Please rely on the bar scale on each map sheet for map measurements.

Source of Map: Natural Resources Conservation Service

Web Soil Survey URL:

Coordinate System: Web Mercator (EPSG:3857)

Maps from the Web Soil Survey are based on the Web Mercator projection, which preserves direction and shape but distorts distance and area. A projection that preserves area, such as the Albers equal-area conic projection, should be used if more accurate calculations of distance or area are required.

This product is generated from the USDA-NRCS certified data as of the version date(s) listed below.

Soil Survey Area: Flathead County Area and Part of Lincoln County, Montana

Survey Area Data: Version 20, Aug 28, 2024

Soil Survey Area: Upper Flathead Valley Area, Montana

Survey Area Data: Version 21, Aug 28, 2024

Your area of interest (AOI) includes more than one soil survey area. These survey areas may have been mapped at different scales, with a different land use in mind, at different times, or at different levels of detail. This may result in map unit symbols, soil properties, and interpretations that do not completely agree across soil survey area boundaries.

Soil map units are labeled (as space allows) for map scales 1:50,000 or larger.

Date(s) aerial images were photographed: Aug 31, 2021—Oct 12, 2021

The orthophoto or other base map on which the soil lines were compiled and digitized probably differs from the background imagery displayed on these maps. As a result, some minor shifting of map unit boundaries may be evident.

Hydrologic Soil Group

Map unit symbol	Map unit name	Rating	Acres in AOI	Percent of AOI
71D	Kingspoint gravelly silt loam, 4 to 15 percent slopes	B	11.5	0.5%
85C	Kila ashy silt loam, 0 to 8 percent slopes	B	22.9	0.9%
711F	Kingspoint-Rock outcrop-Sharrott complex, 15 to 50 percent slopes	B	75.0	3.0%
902F	Wimper-Rock outcrop-Castner complex 15 to 50 percent slopes	B	0.3	0.0%
931G	Repp-Kingspoint-Rock outcrop complex, 40 to 80 percent slopes	B	36.9	1.5%
1071E	Kingspoint gravelly silt loam, 15 to 30 percent slopes, lake effect	B	7.4	0.3%
W	Water		136.0	5.4%
Subtotals for Soil Survey Area			290.1	11.6%
Totals for Area of Interest			2,507.6	100.0%

Map unit symbol	Map unit name	Rating	Acres in AOI	Percent of AOI
85C	Kila ashy silt loam, 0 to 8 percent slopes	B	1.7	0.1%
711F	Kingspoint-Rock outcrop-Sharrott complex, 15 to 50 percent slopes	B	59.2	2.4%
931G	Repp-Kingspoint-Rock outcrop complex, 40 to 80 percent slopes	B	159.4	6.4%
Aa	Alluvial land, poorly drained	C	149.4	6.0%
Cd	Corvallis silty clay loam, 0 to 3 percent slopes	C	64.1	2.6%
Ce	Creston silt loam, 0 to 3 percent slopes	B	39.3	1.6%
Db	Demers-Kalispell silt loam, 3 to 7 percent slopes	C	39.0	1.6%

Map unit symbol	Map unit name	Rating	Acres in AOI	Percent of AOI
Kt	Kalispell loam, moderately deep over sand, 12 to 40 percent slopes	B	9.8	0.4%
Kv	Kalispell silt loam, moderately deep over sand, 0 to 7 percent slopes	B	607.0	24.2%
Ma	Made land		147.3	5.9%
Mr	Mountainous land	B	63.7	2.5%
Ms	Muck and peat	A/D	58.1	2.3%
Sd	Somers silt loam, 0 to 3 percent slopes	C	0.9	0.0%
Se	Somers silt loam, 3 to 7 percent slopes	C	0.4	0.0%
Sg	Somers silty clay loam, 0 to 3 percent slopes	C	130.5	5.2%
Th	Tuffit-Somers silty clay loams, 0 to 5 percent slopes	C	3.2	0.1%
W	Water		684.4	27.3%
Subtotals for Soil Survey Area			2,217.4	88.4%
Totals for Area of Interest			2,507.6	100.0%

Description

Hydrologic soil groups are based on estimates of runoff potential. Soils are assigned to one of four groups according to the rate of water infiltration when the soils are not protected by vegetation, are thoroughly wet, and receive precipitation from long-duration storms.

The soils in the United States are assigned to four groups (A, B, C, and D) and three dual classes (A/D, B/D, and C/D). The groups are defined as follows:

Group A. Soils having a high infiltration rate (low runoff potential) when thoroughly wet. These consist mainly of deep, well drained to excessively drained sands or gravelly sands. These soils have a high rate of water transmission.

Group B. Soils having a moderate infiltration rate when thoroughly wet. These consist chiefly of moderately deep or deep, moderately well drained or well drained soils that have moderately fine texture to moderately coarse texture. These soils have a moderate rate of water transmission.

Group C. Soils having a slow infiltration rate when thoroughly wet. These consist chiefly of soils having a layer that impedes the downward movement of water or soils of moderately fine texture or fine texture. These soils have a slow rate of water transmission.

Group D. Soils having a very slow infiltration rate (high runoff potential) when thoroughly wet. These consist chiefly of clays that have a high shrink-swell potential, soils that have a high water table, soils that have a claypan or clay layer at or near the surface, and soils that are shallow over nearly impervious material. These soils have a very slow rate of water transmission.

If a soil is assigned to a dual hydrologic group (A/D, B/D, or C/D), the first letter is for drained areas and the second is for undrained areas. Only the soils that in their natural condition are in group D are assigned to dual classes.

Rating Options

Aggregation Method: Dominant Condition

Component Percent Cutoff: None Specified

Tie-break Rule: Higher

Appendix C: Federal Emergency Management Agency Index Map



FEMA




FEMA Digital Flood Map Products

- **FIRM Panel Image:** Flood Insurance Rate Maps (FIRM) are digital images of flood hazard maps. The images are digital pictures of entire flood map panels that can be viewed and printed from a computer. Most communities and counties have many map panels to cover the entire jurisdiction and an index map that shows the location of each map panel.
- **FIRM Worldfile:** A TFW or PGW file may accompany your flood hazard map. They are used to help view the flood maps in GIS applications.

FIRM Panel Images are TIF or PNG image files and have file names with a Community or County ID followed by a 4-digit panel number and letter suffix representing a version (e.g. 12345C0123F.tif). The FIRM worldfiles will have the same filenames but with a .tfw or .pgw extension.

FIRM Panel Images can be viewed using most freely available image viewer applications. You can also use the FIRMette-Desktop software available from the FEMA Flood Map Service Center (MSC) website at msc.fema.gov/portal/resources/firmettes. FIRM images can also be viewed in specialized GIS software where the worldfiles are used to make the images compatible with other GIS data. See the [MSC Products and Tools Overview page](#) for more information on available data and tools for using FEMA's flood risk data.

For more information on available digital products, visit FEMA's Map Service Center website at <https://msc.fema.gov> or call the FEMA Map Information eXchange (FMIX) at 877-336-2627.

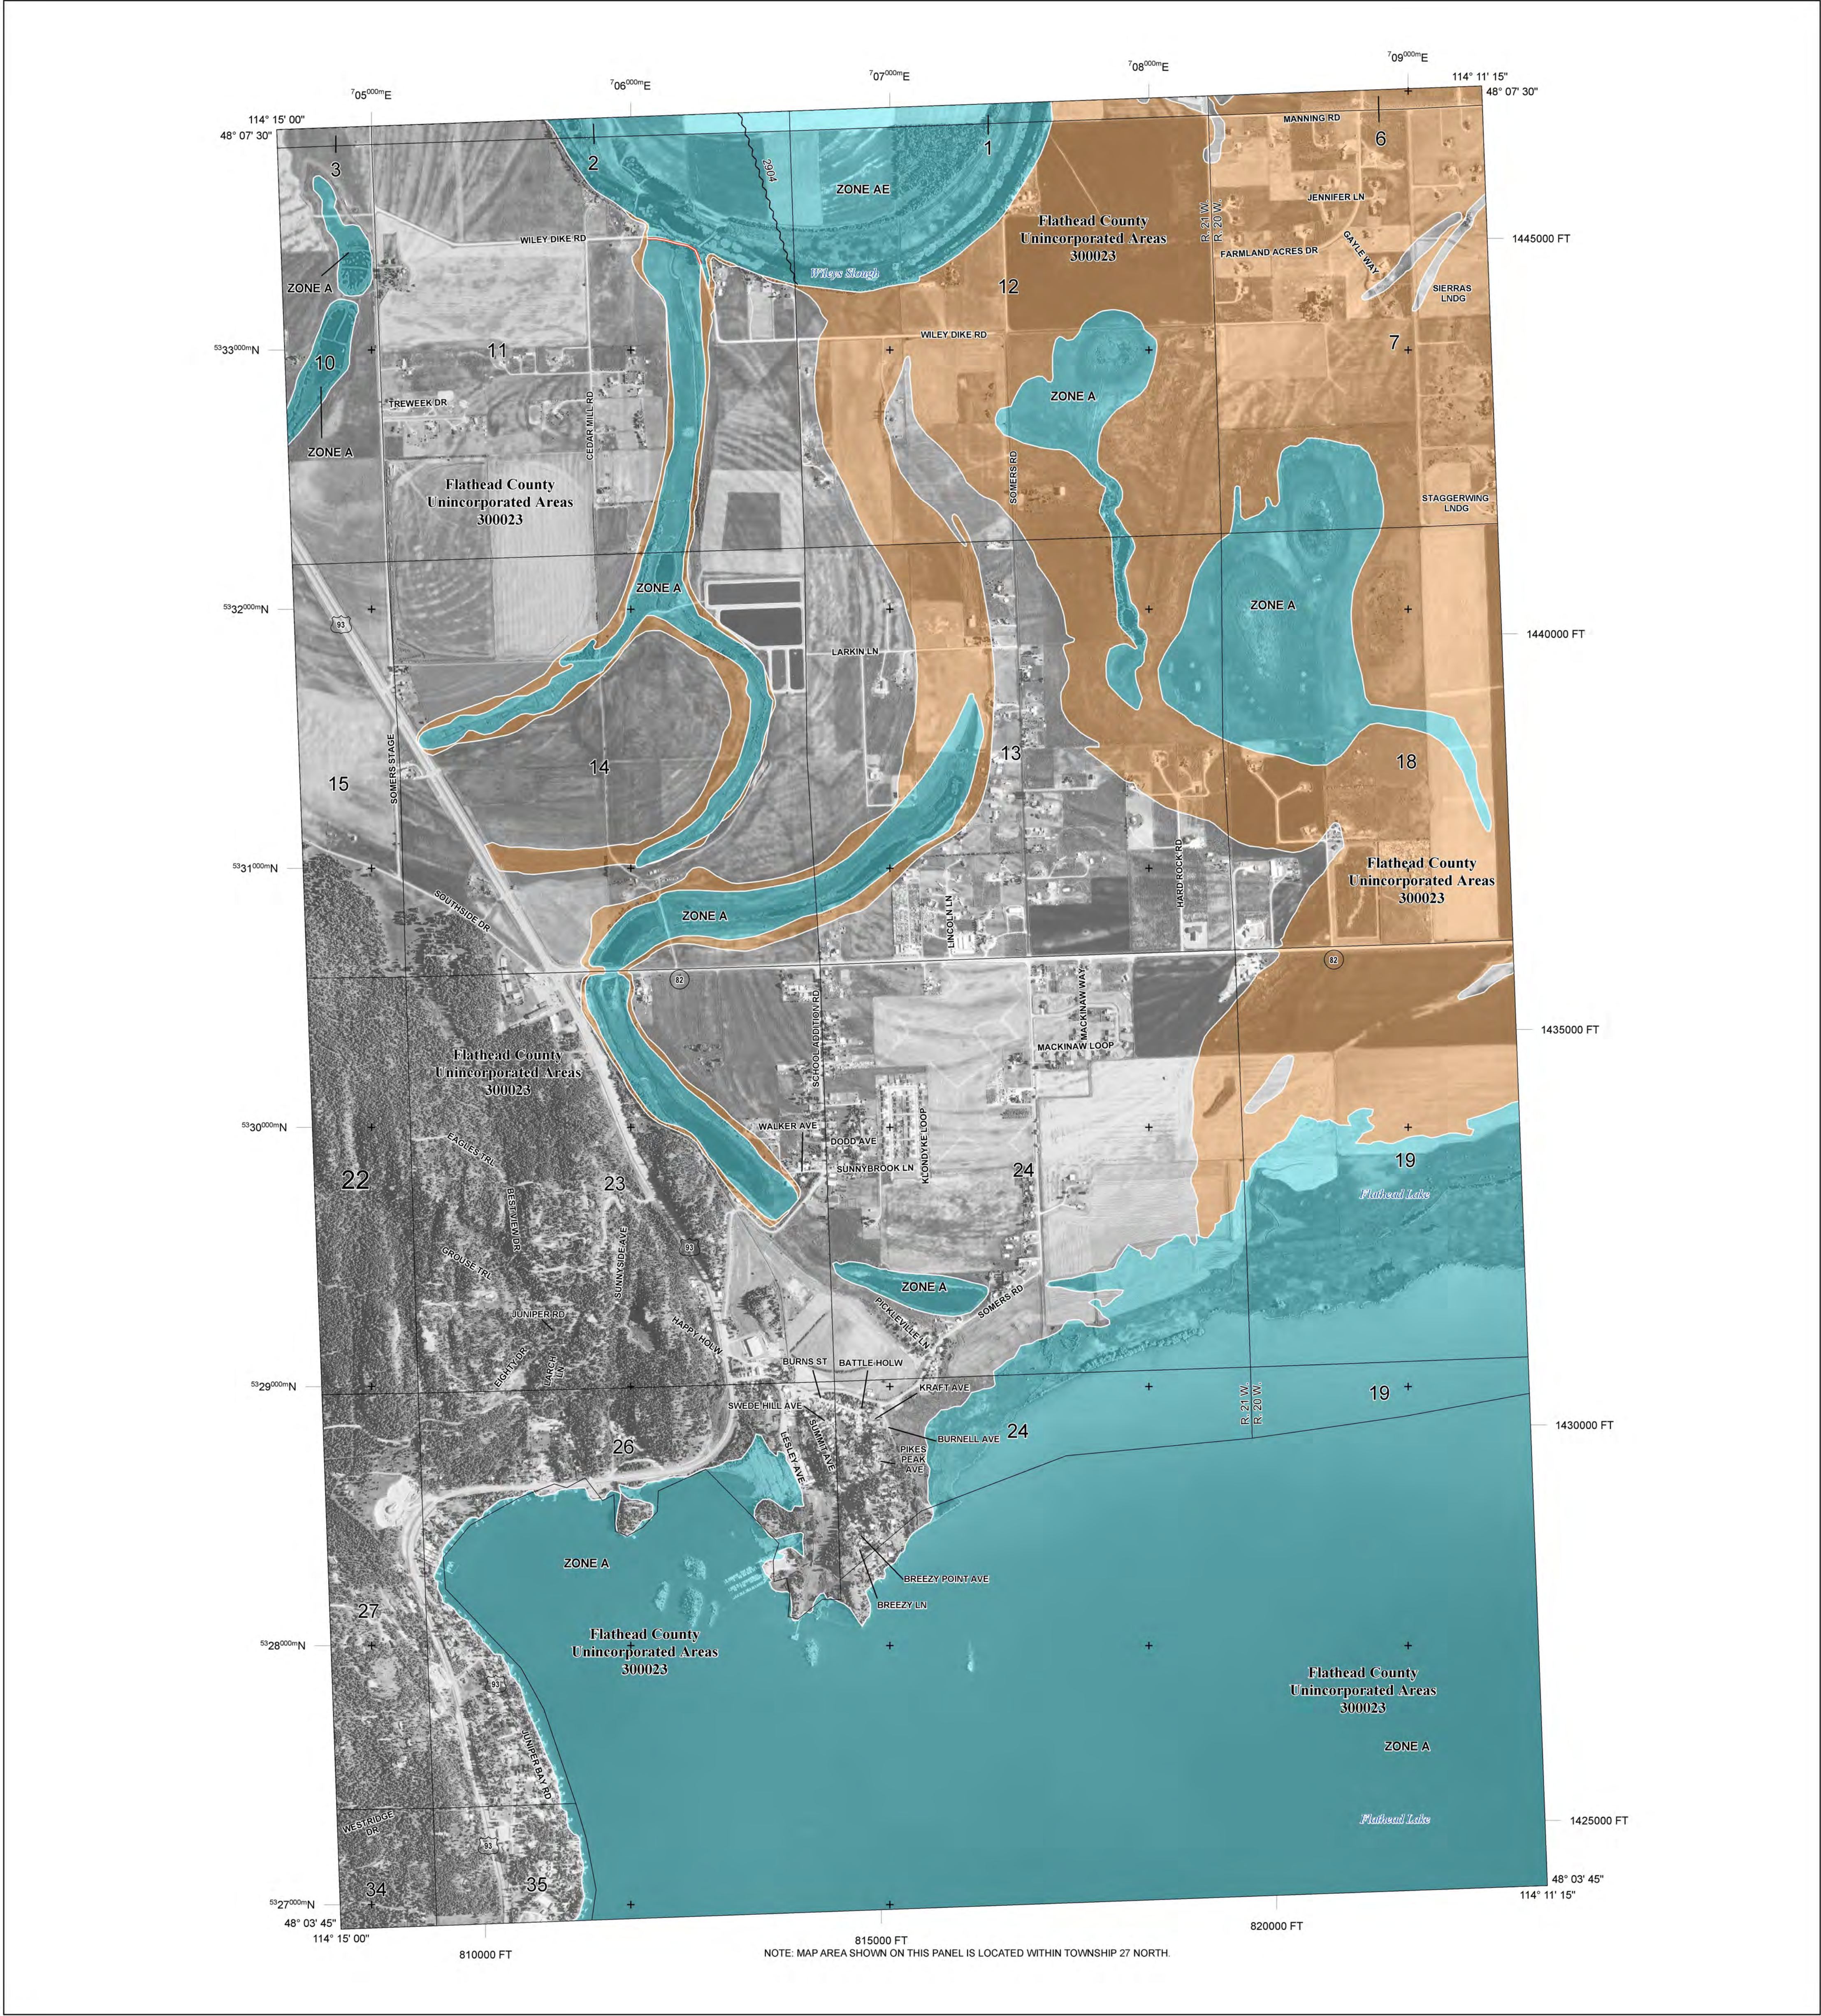

FLOOD HAZARD INFORMATION

SEE FIS REPORT FOR ZONE DESCRIPTIONS AND INDEX MAP THE INFORMATION DEPICTED ON THIS MAP AND SUPPORTING DOCUMENTATION ARE ALSO AVAILABLE IN DIGITAL FORMAT AT HTTP://MSC.FEMA.GOV	
SPECIAL FLOOD HAZARD AREAS	Without Base Flood Elevation (BFE) Zone A, V, A99
	With BFE or Depth Zone AE, AO, AH, VE, AR
	Regulatory Floodway
OTHER AREAS OF FLOOD HAZARD	0.2% Annual Chance Flood Hazard, Areas of 1% annual chance flood with average depth less than one foot or with drainage areas of less than one square mile Zone X
	Future Conditions 1% Annual Chance Flood Hazard Zone X
	Area with Reduced Flood Risk due to Levee See Notes. Zone X
OTHER AREAS	Areas Determined to be Outside the 0.2% Annual Chance Floodplain Zone X
	Area of Undetermined Flood Hazard Zone D
GENERAL STRUCTURES	Channel, Culvert, or Storm Sewer
	Accredited or Provisionally Accredited Levee, Dike, or Floodwall
	Non-accredited Levee, Dike, or Floodwall
OTHER FEATURES	Cross Sections with 1% Annual Chance Water Surface Elevation (BFE) 18.2 17.5
	Coastal Transect
	Coastal Transect Baseline
	Profile Baseline
	Hydrographic Feature
	Base Flood Elevation Line (BFE)
	Limit of Study
	Jurisdiction Boundary

NOTES TO USERS

For information and questions about this map, available products associated with this FIRM including historic versions of this FIRM, how to order products or the National Flood Insurance Program in general, please call the FEMA Map Information eXchange at 1-877-FEMA-MAP (1-877-336-2627) or visit the FEMA Map Service Center website at <http://msc.fema.gov>. Available products may include previously issued Letters of Map Change, a Flood Insurance Study Report, and/or digital versions of this map. Many of these products can be ordered or obtained directly from the website. Users may determine the current map date for each FIRM panel by visiting the FEMA Map Service Center website or by calling the FEMA Map Information eXchange.


Communities annexing land on adjacent FIRM panels must obtain a current copy of the adjacent panel as well as the current FIRM index. These may be ordered directly from the Map Service Center at the number listed above.

For community and countywide map dates refer to the Flood Insurance Study report for this jurisdiction.


To determine if flood insurance is available in the community, contact your insurance agent or call the National Flood Insurance Program at 1-800-638-6620.

Base map information shown on this FIRM was provided in digital format by the United States Department of Agriculture (USDA). This information was derived from 2011 National Agriculture Imagery Program (NAIP).

SCALE

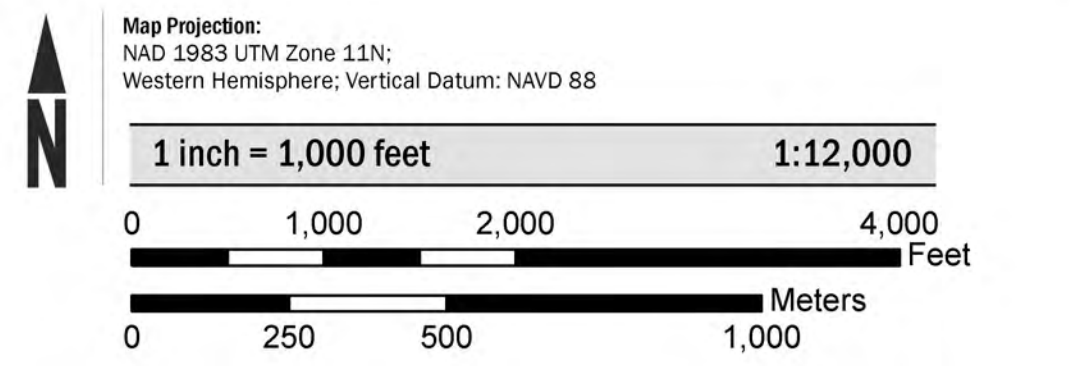

PANEL LOCATOR

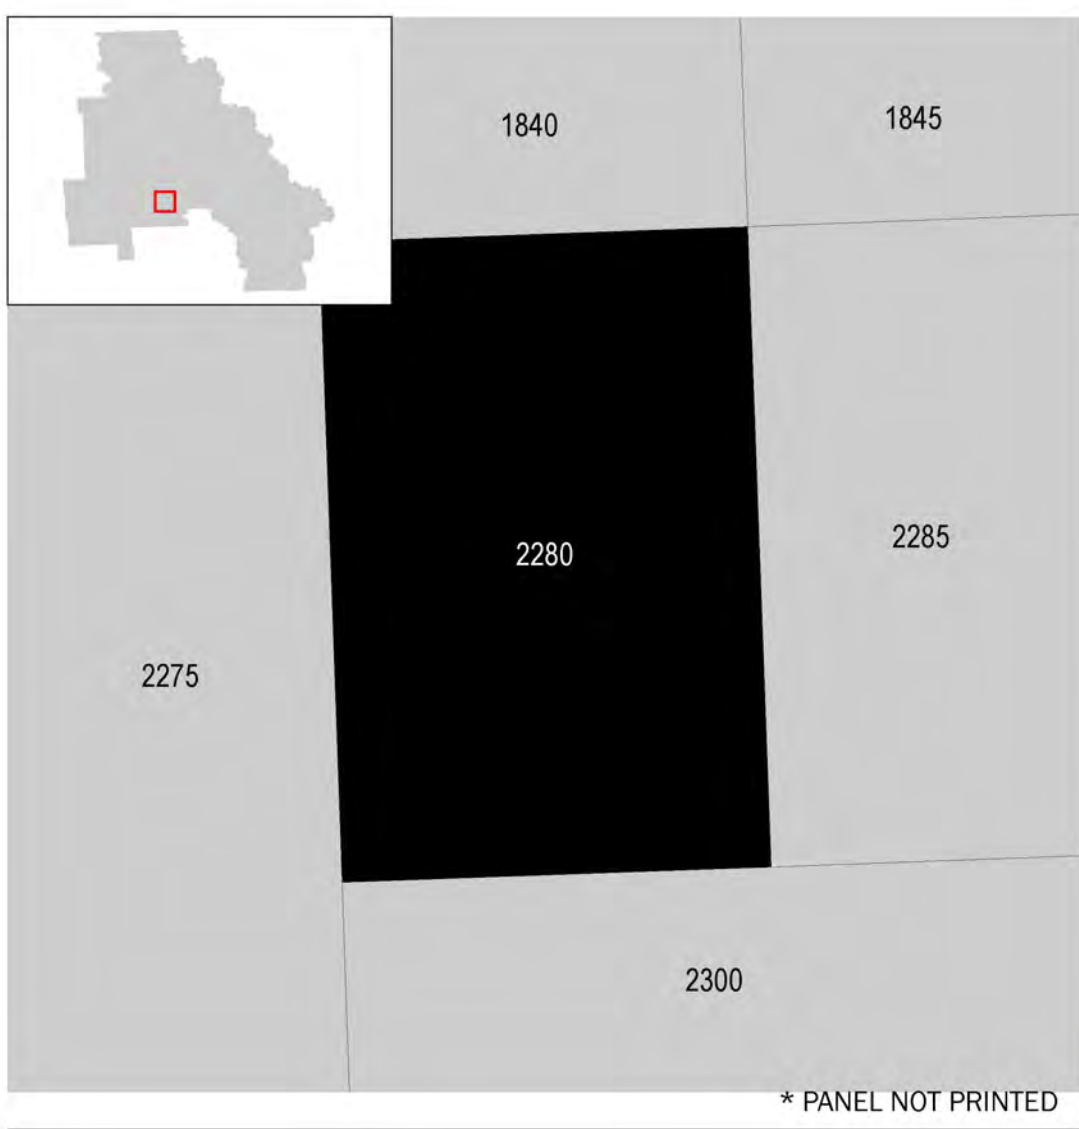

National Flood Insurance Program

NATIONAL FLOOD INSURANCE PROGRAM
FLOOD INSURANCE RATE MAP

FLATHEAD COUNTY, MONTANA
AND INCORPORATED AREAS

PANEL 2280 OF 3475

Panel Contains:

COMMUNITY	NUMBER	PANEL	SUFFIX
FLATHEAD COUNTY	300023	2280	J

VERSION NUMBER
2.2.2.1


MAP NUMBER
30029C2280J

EFFECTIVE DATE
November 04, 2015

Appendix D: Wetland Areas from Montana Natural Heritage Program



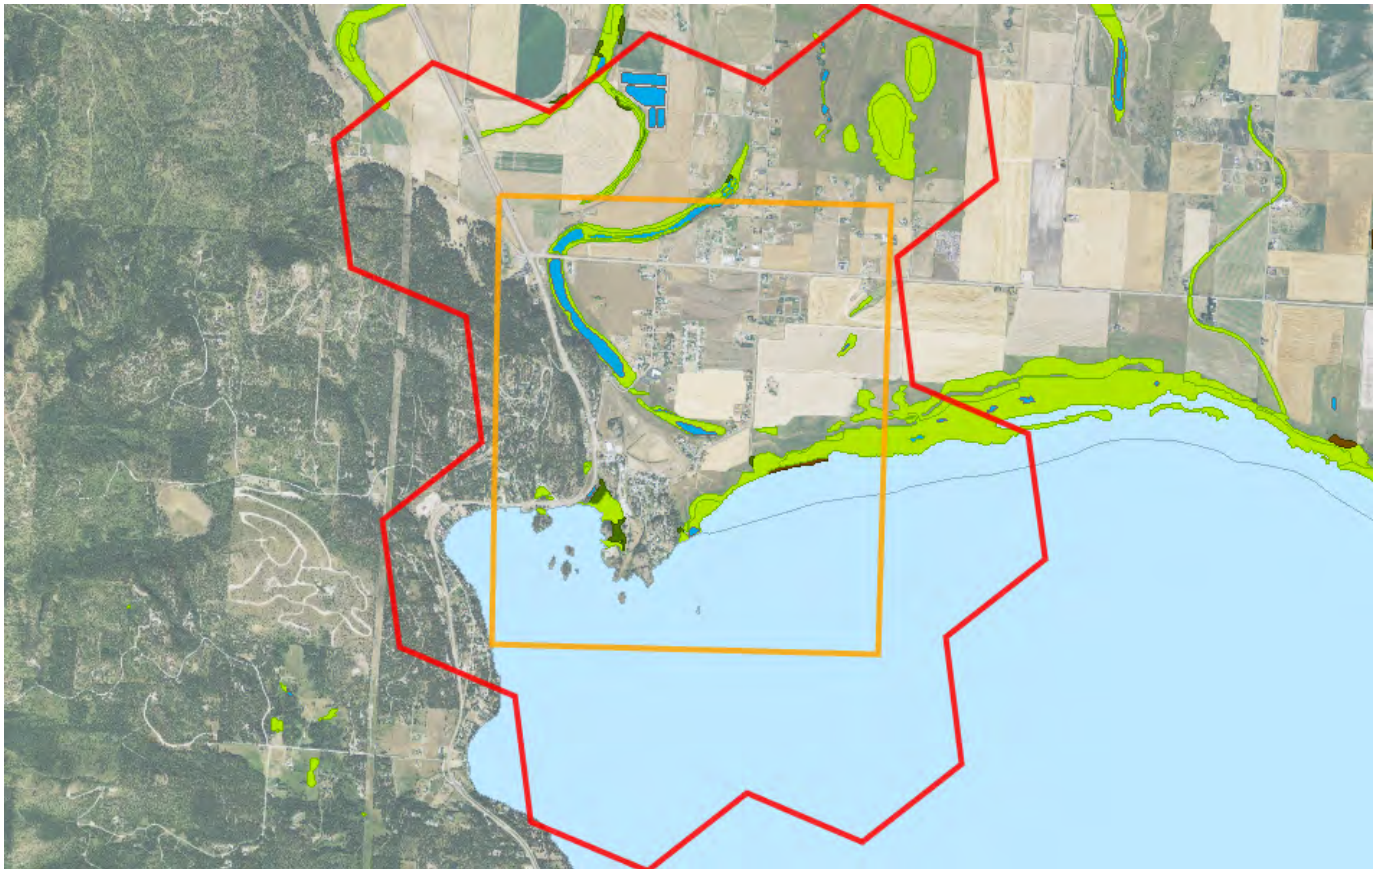


Wetland and Riparian

Summarized by: (Custom Area of Interest)



Wetland and Riparian Mapping


P - Palustrine

 UB - Unconsolidated Bottom			P - Palustrine, UB - Unconsolidated Bottom	
F - Semipermanently Flooded 21 Acres			Wetlands where mud, silt or similar fine particles cover at least 25% of the bottom, and where vegetation cover is less than 30%.	
x - Excavated 21 Acres PUBFx				
 AB - Aquatic Bed			P - Palustrine, AB - Aquatic Bed	
F - Semipermanently Flooded 41 Acres			Wetlands with vegetation growing on or below the water surface for most of the growing season.	
(no modifier) 17 Acres PABF				
h - Diked/Impounded 21 Acres PABFh				
x - Excavated 3 Acres PABFx				
G - Intermittently Exposed 2 Acres				
(no modifier) 2 Acres PABG				
 US - Unconsolidated Shore			P - Palustrine, US - Unconsolidated Shore	
C - Seasonally Flooded 3 Acres			Wetlands with less than 75% areal cover of stones, boulders, or bedrock. AND with less than 30% vegetative cover AND the wetland is irregularly exposed due to seasonal or irregular flooding and subsequent drying.	
(no modifier) 3 Acres PUSC				
 EM - Emergent			P - Palustrine, EM - Emergent	
A - Temporarily Flooded 88 Acres			Wetlands with erect, rooted herbaceous vegetation present during most of the growing season.	
(no modifier) 87 Acres PEMA				
h - Diked/Impounded 1 Acres PEMAh				
C - Seasonally Flooded 143 Acres				
(no modifier) 79 Acres PEMC				
d - Partially Drained/Ditched 6 Acres PEMCd				
h - Diked/Impounded 52 Acres PEMCh				
x - Excavated 6 Acres PEMCx				
F - Semipermanently Flooded 94 Acres				
(no modifier) <1 Acres PEMF				
h - Diked/Impounded 94 Acres PEMFh				
 SS - Scrub-Shrub			P - Palustrine, SS - Scrub-Shrub	
			Wetlands dominated by woody vegetation less than 6 meters	

A - Temporarily Flooded		10 Acres	(20 feet) tall. Woody vegetation includes tree saplings and trees that are stunted due to environmental conditions.
(no modifier)		6 Acres	
h - Diked/Impounded		4 Acres	
L - Lacustrine (Lakes)			
1 - Limnetic			
UB	UB - Unconsolidated Bottom		L - Lacustrine (Lakes), 1 - Limnetic, UB - Unconsolidated Bottom Deep waterbodies with mud or silt covering at least 25% of the bottom.
H	H - Permanently Flooded	2,317 Acres	
h	h - Diked/Impounded	2,317 Acres	
2 - Littoral			
AB	AB - Aquatic Bed		L - Lacustrine (Lakes), 2 - Littoral, AB - Aquatic Bed Shorelines with vegetation growing on or below the water surface for most of the growing season.
G	G - Intermittently Exposed	190 Acres	
h	h - Diked/Impounded	190 Acres	
Rp - Riparian			
2 - Lentic			
FO	FO - Forested		Rp - Riparian, 2 - Lentic, FO - Forested This riparian class has woody vegetation that is greater than 6 meters (20 feet) tall.
	(no modifier)	3 Acres	

Land Management

Summarized by: (Custom Area of Interest)

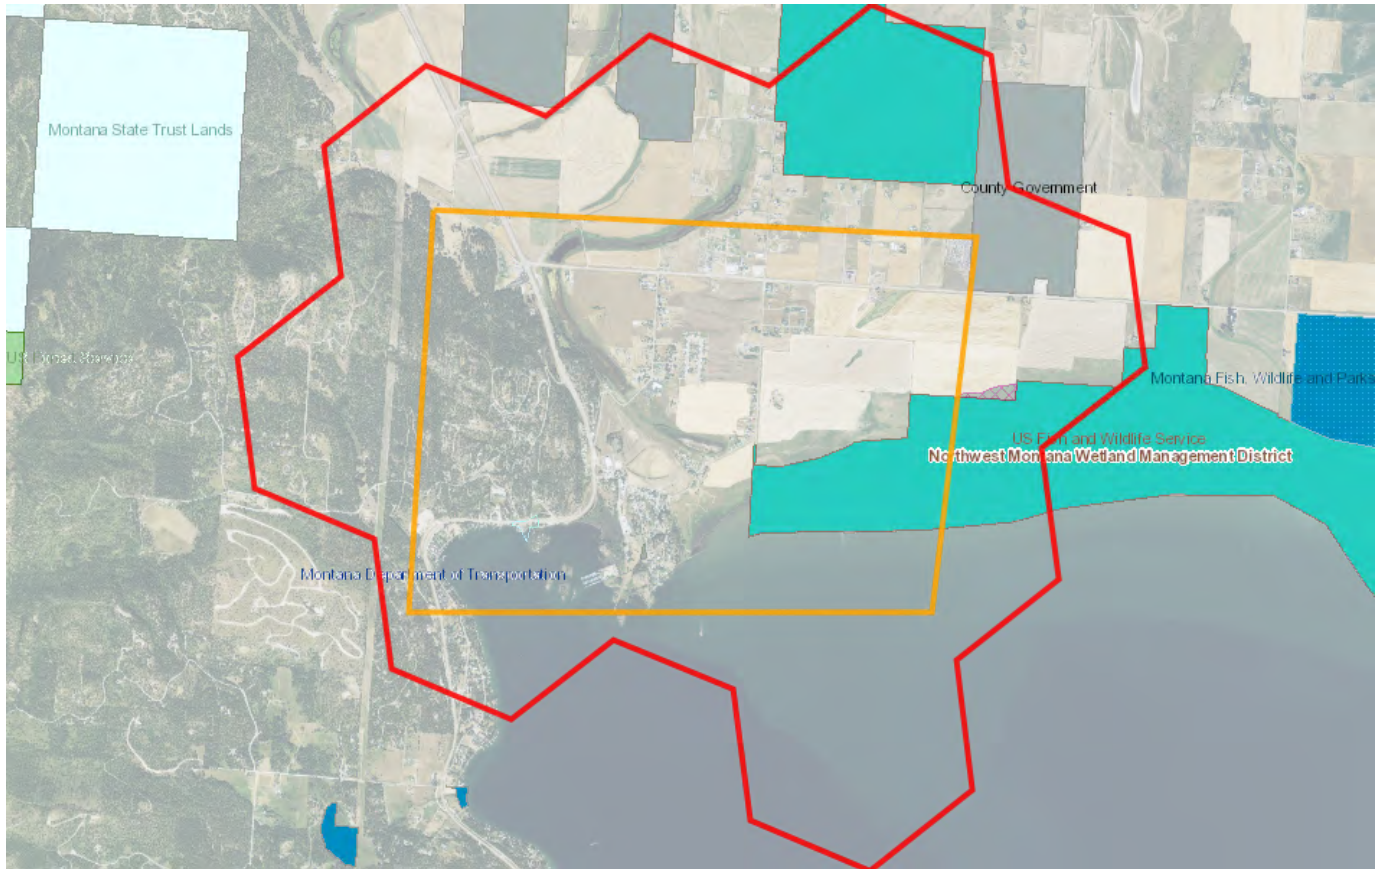

Land Management Summary

	Ownership	Tribal	Easements	Other Boundaries (possible overlap)
Public Lands	1,178 Acres (17%)			
Federal	898 Acres (13%)			
US Fish and Wildlife Services	898 Acres (13%)			
USFWS Owned	898 Acres (13%)			
USFWS Wetland Management Districts				898 Acres
Northwest Montana Wetland Management District				898 Acres
State				
Montana Fish, Wildlife and Parks				
MTFWP Fishing Access Sites				4 Acres
Somers Fishing Access Site				4 Acres
Local	280 Acres (4%)			
Local Government	280 Acres (4%)			
Local Government Owned	280 Acres (4%)			
Conservation Easements			7 Acres (<1%)	
Federal			7 Acres (<1%)	
US Department of Agriculture			7 Acres (<1%)	
Private Lands or Unknown Ownership	5,849 Acres (83%)			

Introduction to Land Management

Within the report area you have requested, land management information is summarized by acres of federal, state, and local government lands, tribal reservation boundaries, private conservation lands, and federal, state, local, and private conservation easements. Acreage for “Owned”, “Tribal”, or “Easement” categories represents non-overlapping areas that may be totaled. However, “Other Boundaries” represents managed areas such as National Forest boundaries containing private inholdings and other mixed ownership which may cause boundaries to overlap (e.g. a wilderness area within a forest). Therefore, acreages may not total in a straight-forward manner.

Because information on land stewardship is critical to effective land management, the Montana Natural Heritage Program (MTNHP) began compiling ownership and management data in 1997. The goal of the Montana Land Management Database is to manage a single, statewide digital data set that incorporates information from both public and private entities. The database assembles information on public lands, private conservation lands, and conservation easements held by state and federal agencies and land trusts and is updated on a regular basis. Since 2011, the Information Management group in the Montana State Library’s Digital Library Division has led the Montana Land Management Database in partnership with the MTNHP.

Public and private conservation land polygons are attributed with the name of the entity that owns it. The data are derived from the statewide [Montana Cadastral Parcel layer](#). Conservation easement data shows land parcels on which a public agency or qualified land trust has placed a conservation easement in cooperation with the landowner. The dataset contains no information about ownership or status of the mineral estate. For questions about the dataset or to report errors, please contact the Montana Natural Heritage Program at (406) 444-5363 or mtnhp@mt.gov. You can download various components of the Land Management Database and view associated metadata at the Montana State Library’s [GIS Data List](#) at the following links:

[Public Lands](#)

[Conservation Easements](#)

[Private Conservation Lands](#)

[Managed Areas](#)

Map features in the Montana Land Management Database or summaries provided in this report are not intended as a legal depiction of public or private surface land ownership boundaries and should not be used in place of a survey conducted by a licensed land surveyor. Similarly, map features do not imply public access to any lands. The Montana Natural Heritage Program makes no representations or warranties whatsoever with respect to the accuracy or completeness of this data and assumes no responsibility for the suitability of the data for a particular purpose. The Montana Natural Heritage Program will not be liable for any damages incurred as a result of errors displayed here. Consumers of this information should review or consult the primary data and information sources to ascertain the viability of the information for their purposes.

Introduction to Wetland and Riparian

Within the report area you have requested, wetland and riparian mapping is summarized by acres of each classification present. Summaries are only provided for modern MTNHP wetland and riparian mapping and not for outdated (NWI Legacy) or incomplete (NWI Scalable) mapping efforts; [described here](#). MTNHP has made all three of these datasets and associated metadata available for separate download on the Montana [Wetland and Riparian Framework](#) web page.

Wetland and Riparian mapping is one of 15 [Montana Spatial Data Infrastructure](#) framework layers considered vital for making statewide maps of Montana and understanding its geography. The wetland and riparian framework layer consists of spatial data representing the extent, type, and approximate location of wetlands, riparian areas, and deep water habitats in Montana.

Wetland and riparian mapping is completed through photointerpretation of 1-m resolution color infrared aerial imagery acquired from 2005 or later. A coding convention using letters and numbers is assigned to each mapped wetland. These letters and numbers describe the broad landscape context of the wetland, its vegetation type, its water regime, and the kind of alterations that may have occurred. Ancillary data layers such as topographic maps, digital elevation models, soils data, and other aerial imagery sources are also used to improve mapping accuracy. Wetland mapping follows the federal Wetland Mapping Standard and classifies wetlands according to the Cowardin classification system of the National Wetlands Inventory (NWI) (Cowardin et al. 1979, FGDC Wetlands Subcommittee 2013). Federal, State, and local regulatory agencies with jurisdiction over wetlands may define and describe wetlands differently than the NWI. Similar coding, based on U.S. Fish and Wildlife Service conventions, is applied to riparian areas (U.S. Fish and Wildlife Service 2009). These are mapped areas where vegetation composition and growth is influenced by nearby water bodies, but where soils, plant communities, and hydrology do not display true wetland characteristics. **These data are intended for use at a scale of 1:12,000 or smaller. Mapped wetland and riparian areas do not represent precise boundaries and digital wetland data cannot substitute for an on-site determination of jurisdictional wetlands.**

See detailed overviews, with examples, of both wetland and riparian classification systems and associated codes as a [storymap](#) and companion [guide](#)

Literature Cited

- Cowardin, L.M., V. Carter, F.C. Golet, and E.T. LaRoe. 1979. Classification of wetlands and deepwater habitats of the United States. U.S. Fish and Wildlife Service, FWS/OBS-79/31. Washington, D.C. 103pp.
- Federal Geographic Data Committee. 2013. Classification of wetlands and deepwater habitats of the United States. FGDC-STD-004-2013. Second Edition. Wetlands Subcommittee, Federal Geographic Data Committee and U.S. Fish and Wildlife Service, Washington, D.C.
- U.S. Fish and Wildlife Services. 2009. A system for mapping riparian areas in the western United States. Division of Habitat and Resource Conservation, Branch of Resource and Mapping Support, Arlington, Virginia.

Appendix E: Census Data

RACE		United States [®] Census Bureau
Note: The table shown may have been modified by user selections. Some information may be missing.		
DATA NOTES		
TABLE ID:	P1	
SURVEY/PROGRAM:	Decennial Census	
VINTAGE:	2020	
DATASET:	DECENNIALPL2020	
PRODUCT:	DEC Redistricting Data (PL 94-171)	
UNIVERSE:	Total population	
MLA:	U.S. Census Bureau. "RACE." Decennial Census, DEC Redistricting Data (PL 94-171), Table P1, 2020, https://data.census.gov/table/DECENNIALPL2020.P1?q=population of somers montana . Accessed on December 3, 2024.	
FTP URL:	https://www2.census.gov/programs-surveys/decennial/2020/data/	
API URL:	https://api.census.gov/data/2020/dec/pl	
USER SELECTIONS		
GEOS	Somers CDP, Montana	
EXCLUDED COLUMNS	None	
APPLIED FILTERS	None	
APPLIED SORTS	None	
PIVOT & GROUPING		
PIVOT COLUMNS	None	
PIVOT MODE	Off	
ROW GROUPS	None	

Table: DECENNIALPL2020.P1

VALUE COLUMNS	None
WEB ADDRESS	https://data.census.gov/table/DECENNIALPL2020.P1?q=population%20of%20somers%20montana
TABLE NOTES	
	Note: For information on data collection, confidentiality protection, nonsampling error, and definitions, see 2020 Census Redistricting Data (Public Law 94-171) Summary File Technical Documentation.
	For information on the statistical methods used to protect confidentiality in these tables, see Disclosure Avoidance and the 2020 Census.
	Source: U.S. Census Bureau, 2020 Census Redistricting Data (Public Law 94-171)
COLUMN NOTES	None

Table: DECENNIALPL2020.P1

Label	Somers CDP, Montana
Total:	1,049
Population of one race:	995
White alone	985
Black or African American alone	1
American Indian and Alaska Native alone	2
Asian alone	3
Native Hawaiian and Other Pacific Islander alone	0
Some Other Race alone	4
Population of two or more races:	54
Population of two races:	52
White; Black or African American	2
White; American Indian and Alaska Native	27
White; Asian	4
White; Native Hawaiian and Other Pacific Islander	0
White; Some Other Race	17
Black or African American; American Indian and Alaska Native	0
Black or African American; Asian	0
Black or African American; Native Hawaiian and Other Pacific Islander	0
Black or African American; Some Other Race	0

Table: DECENNIALPL2020.P1

Label	Somers CDP, Montana
American Indian and Alaska Native; Asian	0
American Indian and Alaska Native; Native Hawaiian and Other Pacific Islander	0
American Indian and Alaska Native; Some Other Race	1
Asian; Native Hawaiian and Other Pacific Islander	1
Asian; Some Other Race	0
Native Hawaiian and Other Pacific Islander; Some Other Race	0
Population of three races:	2
White; Black or African American; American Indian and Alaska Native	0
White; Black or African American; Asian	0
White; Black or African American; Native Hawaiian and Other Pacific Islander	0
White; Black or African American; Some Other Race	1
White; American Indian and Alaska Native; Asian	0
White; American Indian and Alaska Native; Native Hawaiian and Other Pacific Islander	0

Table: DECENNIALPL2020.P1

Label	Somers CDP, Montana
White; American Indian and Alaska Native; Some Other Race	1
White; Asian; Native Hawaiian and Other Pacific Islander	0
White; Asian; Some Other Race	0
White; Native Hawaiian and Other Pacific Islander; Some Other Race	0
Black or African American; American Indian and Alaska Native; Asian	0
Black or African American; American Indian and Alaska Native; Native Hawaiian and Other Pacific Islander	0
Black or African American; American Indian and Alaska Native; Some Other Race	0
Black or African American; Asian; Native Hawaiian and Other Pacific Islander	0
Black or African American; Asian; Some Other Race	0
Black or African American; Native Hawaiian and Other Pacific Islander; Some Other Race	0

Table: DECENNIALPL2020.P1

Label	Somers CDP, Montana
American Indian and Alaska Native; Asian; Native Hawaiian and Other Pacific Islander	0
American Indian and Alaska Native; Asian; Some Other Race	0
American Indian and Alaska Native; Native Hawaiian and Other Pacific Islander; Some Other Race	0
Asian; Native Hawaiian and Other Pacific Islander; Some Other Race	0
Population of four races:	0
White; Black or African American; American Indian and Alaska Native; Asian	0
White; Black or African American; American Indian and Alaska Native; Native Hawaiian and Other Pacific Islander	0
White; Black or African American; American Indian and Alaska Native; Some Other Race	0
White; Black or African American; Asian; Native Hawaiian and Other Pacific Islander	0

Table: DECENNIALPL2020.P1

Label	Somers CDP, Montana
White; Black or African American; Asian; Some Other Race	0
White; Black or African American; Native Hawaiian and Other Pacific Islander; Some Other Race	0
White; American Indian and Alaska Native; Asian; Native Hawaiian and Other Pacific Islander	0
White; American Indian and Alaska Native; Asian; Some Other Race	0
White; American Indian and Alaska Native; Native Hawaiian and Other Pacific Islander; Some Other Race	0
White; Asian; Native Hawaiian and Other Pacific Islander; Some Other Race	0
Black or African American; American Indian and Alaska Native; Asian; Native Hawaiian and Other Pacific Islander	0
Black or African American; American Indian and Alaska Native; Asian; Some Other Race	0

Table: DECENNIALPL2020.P1

Label	Somers CDP, Montana
Black or African American; American Indian and Alaska Native; Native Hawaiian and Other Pacific Islander; Some Other Race	0
Black or African American; Asian; Native Hawaiian and Other Pacific Islander; Some Other Race	0
American Indian and Alaska Native; Asian; Native Hawaiian and Other Pacific Islander; Some Other Race	0
Population of five races:	0
White; Black or African American; American Indian and Alaska Native; Asian; Native Hawaiian and Other Pacific Islander	0
White; Black or African American; American Indian and Alaska Native; Asian; Some Other Race	0
White; Black or African American; American Indian and Alaska Native; Native Hawaiian and Other Pacific Islander; Some Other Race	0
White; Black or African American; Asian; Native Hawaiian and Other Pacific Islander; Some Other Race	0

Table: DECENNIALPL2020.P1

Label	Somers CDP, Montana
White; American Indian and Alaska Native; Asian; Native Hawaiian and Other Pacific Islander; Some Other Race	0
Black or African American; American Indian and Alaska Native; Asian; Native Hawaiian and Other Pacific Islander; Some Other Race	0
Population of six races:	0
White; Black or African American; American Indian and Alaska Native; Asian; Native Hawaiian and Other Pacific Islander; Some Other Race	0

Appendix F: Well Logs and Water Information

260735

WELL LOG REPORT

10(807)

File No. PO 70098-76 LJ

State law requires that the Bureau's copy be filed by the water well driller within 60 days after completion of the well.

1. WELL OWNER

Name Somers Water District

2. CURRENT MAILING ADDRESS

Somers, Montana 59932

3. WELL LOCATION

NE 1/4 SW 1/4 NW 1/4 Section 25

Township 27N N/S Range 21W E/W County Flathead

Gov'n't Lot _____, or Lot _____, Block _____

Subdivision Name _____

Tract Number _____

4. PROPOSED USE:

Domestic ☐ Stock ☐ Irrigation ☐

Other ☐ specify Somers Water Supply

5. TYPE OF WORK:

New well ☒ Method: Dug ☐ Bored ☒

Deepened ☐ Cable ☐ Driven ☐

Reconditioned ☐ Rotary ☒ Jetted ☐

6. DIMENSIONS: Diameter of Hole

Dia. 17 1/2 in. from 0 ft. to 438 ft.

Dia. 10 in. from 438 ft. to 660 ft.

Dia. _____ in. from _____ ft. to _____ ft.

7. CONSTRUCTION DETAILS:

Casing: Steel

Dia. 12 3/4 from +2 ft. to 438 ft.

Threaded ☐ Welded ☒ Dia. 8 5/8 from 433 ft. to 660 ft.

Type A53B Wall Thickness .375/.250

Casing: Plastic

Dia. _____ from _____ ft. to _____ ft.

Weight _____

Dia. _____ from _____ ft. to _____ ft.

PERFORATIONS:

Yes ☐ No ☒

Type of perforator used _____

Size of perforations _____ in. by _____ in.

_____ perforations from _____ ft. to _____ ft.

_____ perforations from _____ ft. to _____ ft.

_____ perforations from _____ ft. to _____ ft.

SCREENS:

Yes ☒ No ☐

Manufacturer's Name Johnson

Type Louvered Model No. _____

Dia. 8 5/8 Slot size _____ from 446 ft. to 466 ft.

Dia. 8 5/8 Slot size _____ from 547 ft. to 567 ft.

Dia. 8 5/8 Slot size _____ from 635 ft. to 665 ft.

GRAVEL PACKED:

Yes ☐ No ☒

Size of gravel _____

Gravel placed from _____ ft. to _____ ft.

GROUTED:

To what depth? 438 ft.

Material used in grouting Cement Grout

8. WELL HEAD COMPLETION:

Pitless Adapter ☐ Yes ☒ No

9. PUMP (if installed)

Manufacturer's name Berkeley

Type Subm Model No. 7T350 HP. 30

10. WELL TEST DATA

The information requested in this section is required for all wells. All depth measurements shall be from the top of the well casing.

All wells under 100 gpm must be tested for a minimum of one hour and provide the following information:

a) Air 8 hours Pump 72 hours Bailor _____

b) Static water level immediately before testing 147'6" ft. If flow-
ing; closed-in pressure _____ psi. _____ gpm.
Flow controlled by: _____ valve, _____ reducers, _____
other, (specify) _____

c) Depth at which pump is set for test 405'

d) The pumping rate: 400 gpm.

e) Pumping water level 260 ft. at 72 hrs. after
pumping began.

f) Duration of test: Pumping time 72 hrs.
g) Recovery time 71 hrs.
h) Recovery water level 147'11" ft. at 71 hrs. after pumping stopped.

Wells intended to yield 100 gpm or more shall be tested for a period of 8 hours or more. The test shall follow the development of the well, and shall be conducted continuously at a constant discharge at least as great as the intended appropriation. In addition to the above information, water level data shall be collected and recorded on the Department's "Aquifer Test Data" form.

NOTE: All wells shall be equipped with an access port 1/2 inch minimum or a pressure gauge that will indicate the shut-in pressure of a flowing well. Removable caps are acceptable as access ports.

11. WAS WELL PLUGGED OR ABANDONED? Yes X No
If yes, how?

12. WELL LOG

Depth (ft.)		Formation
From	To	
0	3	Broken gray rock.
3	26	Light to dark gray rock.
26	30	Gray, greenish-gray and brown rock.
30	49	Light to dark gray, brown-gray, green-brown and brown rock.
49	51	Greenish-gray, tan and yellow-brown slightly fractured rock.
51	53	Light to dark gray and tan rock.
53	64	Light to dark gray, greenish-gray and greenish-brown rock.
64	73	Dark gray rock.
73	75	Gray and grayish-tan rock.
75	80	Grayish-green and gray rock.
80	87	Grayish-brown, grayish-tan and gray rock.
87	91	Grayish-green, gray, orange and brown rock. Fractured 87' to 89'.
91	104	Medium to dark gray rock.
104	123	Grayish-tan, grayish brown and dark brown slightly fractured rock.
123	139	Light to dark gray, grayish-brown, greenish-brown rock with some pyrite.
139	157	Greenish-tan, grayish-tan and gray rock.
157	160	Light to dark gray rock.
160	180	Gray, greenish-gray, orange-brown slightly fractured rock with some calcite in fractures. Seep of water.
180	243	Gray, greenish-gray, orange-brown slightly fractured rock with calcite in fractures. Seeps of water.
243	259	Hard dark gray rock.
259	281	Light to dark brown Fractured rock with white to orange clay streaks and calcite in fractures. 50 GPM tan silty water.

Continued on Page 2

ATTACH ADDITIONAL SHEETS IF NECESSARY

13. DATE COMPLETED May 4, 1990

14. DRILLER/CONTRACTOR'S CERTIFICATION

This well was drilled under my jurisdiction and this report is true to the best of my knowledge.

January 25, 1994
Date

Liberty Drilling & Pump Company, Inc.
Firm Name
600 Highway 93 South
Kalispell, Montana 59901
Address

William F. Osborn
Signature
President
License No. 52

MONTANA DEPARTMENT OF NATURAL RESOURCES & CONSERVATION

1520 EAST SIXTH AVENUE

HELENA, MONTANA 59620-2301

444-6610

DNRC

RECEIVED

JAN 27 1994

MONTANA D.N.R.C.
KALISPELL REGIONAL OFFICE

DEPARTMENT—BUREAU COPY

WA: 140158

LIBERTY DRILLING & PUMP COMPANY, INC.



3850 Highway 93 South Kalispell, Montana 59901
Ph. (406) 752-2809 Fax (406) 756-0029

January 26, 1994
Somers Water District - Tank Well
State Well Log
Page 2 of 2

- 281 - 298 Hard dark gray rock.
- 298 - 301 Fractured light to dark gray rock with brown seams. 10 to 15 gallons per minute water.
- 301 - 329 Hard dark gray rock with calcite seams.
- 329 - 362 Fractured light to dark green rock with brown seams. 75+ gallons per minute water.
- 362 - 428 Hard dark green and dark gray rock.
- 428 - 446 Hard light to dark gray rock.
- 446 - 467 Fractured gray rock with brown seams. Some calcite in fractures. 75 to 100 gallons per minute water.
- 467 - 546 Hard to medium hard dark gray rock.
- 546 - 567 Dark gray rock with some brown seams - rock is slightly fractures. 25+ gallons per minute water.
- 567 - 601 Dark gray and dark green rock in alternate layers.
- 601 - 635 Hard light to dark gray rock with calcite seams.
- 635 - 640 Heavily fractured light to dark gray rock. 200+ gallons per minute water.
- 640 - 655 Slightly fractured dark to light gray rock. 75+ gallons per minute water.
- 655 - 660 Hard dark to light gray rock.

RECEIVED

AUG 4 1970

Montana Bureau of
Mines and Geology

GW 2

029 21N 21W 26 AD 21 HEAD

T. 27 R. 21 -26

County Flathead

STATE OF MONTANA
ADMINISTRATOR OF GROUNDWATER
OFFICE OF STATE ENGINEER

059123

Top of Ground

(Elev. above sea level 2980)

Notice of Completion of Groundwater Appropriation by Means of Well

(Under Chapter 237, Montana Session Laws, 1961)

Owner Myrtle Burgess Address Some, Mont
Driller Homer McCarty Address 945 5th St.

Date of Notice of Appropriation of Groundwater

Date well started May 25/70 Date Completed June 10/70


Type of well Drilled Equipment Used 2 1/2" Bascyns
(dug, driven, bored or (Churn, drill, rotary or
drilled) other) Erie

Water Use: Domestic ☒ Municipal ☐ Other ☒ Irrigation ☐
Industrial ☐ Drainage ☐ Stock ☐

Indicate on the diagram the character and thickness of the different strata met with in drilling, such as soil, clay, shale, gravel, rock or sand, etc. Show depth at which water is encountered, thickness and character of water-bearing strata and height to which water rises in the well.

Size of Drilled Hole	Size and Weight of Casing	From (Feet)	To (Feet)	PERFORATIONS		
				Kind Size	From (Feet)	To (Feet)
<u>7" O.D.</u>	<u>23#</u>		<u>24</u>			

1 ft Top soil
Cobbles + Clay
11 ft
Boulders
15 ft
Rock
42 ft supage
Rock
Water

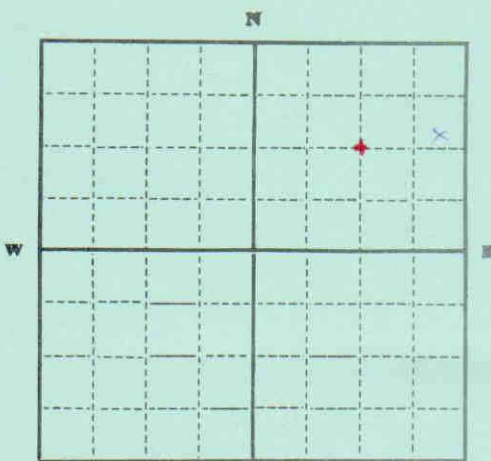

97E 1/4 Sec 26 T. 27 R. 21

Indicate location of well and place of use, if possible. Each small square represents 10 acres.

134 ft

Show exact depth of bottom.

Static Water Level for non-flowing Well 19 feet.

Shut-in Pressure for Flowing Well

Pumping Water Level 35 feet at 25 gal. per minute.

Discharge in gal. per min. of flowing well

How Tested Bailer Length of Test 3 hrs

Remarks: (Gravel packing, cementing, packers, type of shutoff, location of place of use of groundwater if not at well, and any other similar pertinent information, including number of acres irrigated, if used for irrigation)

Driller's License Number 18

Driller's Signature Homer McCarty

This form to be prepared by driller, and three copies to be filed by the owner with the County Clerk and Recorder in the county in which the well is located.

Please answer all questions. If not applicable, so state, otherwise the form will be returned.

Original to the County Clerk and Recorder; duplicate to the State Engineer; Triplicate to the Montana Bureau of Mines and Geology and Quadruplicate for the Appropriator.

m. 81008

WELL LOG REPORT

101808

File No. P070098-76LJ

State law requires that the Bureau's copy be filed by the water well driller within 60 days after completion of the well.

1. WELL OWNER Name <u>Somers Water District</u>		f) Duration of test: Pumping time <u>24</u> hrs. g) Recovery time <u>6</u> hrs. h) Recovery water level <u>276</u> ft. at <u>6</u> hrs. after pumping stopped.	
2. CURRENT MAILING ADDRESS <u>Somers, Montana 59932</u>		Wells intended to yield 100 gpm or more shall be tested for a period of 8 hours or more. The test shall follow the development of the well, and shall be conducted continuously at a constant discharge at least as great as the intended appropriation. In addition to the above information, water level data shall be collected and recorded on the Department's "Aquifer Test Data" form. NOTE: All wells shall be equipped with an access port 1/2 inch minimum or a pressure gauge that will indicate the shut-in pressure of a flowing well. Removable caps are acceptable as access ports.	
3. WELL LOCATION <u>Yacht Club Well</u> Township <u>27N</u> <u>SE</u> <u>1/4</u> <u>NE</u> <u>1/4</u> Section <u>26</u> Range <u>21W</u> E/W County <u>Flathead</u> Gov'n't Lot _____, or Lot _____, Block _____ Subdivision Name _____ Tract Number <u>1 GACA</u>		11. WAS WELL PLUGGED OR ABANDONED? Yes <input checked="" type="checkbox"/> No <input type="checkbox"/> If yes, how? _____	
4. PROPOSED USE: Domestic <input type="checkbox"/> Stock <input type="checkbox"/> Irrigation <input type="checkbox"/> Other <input checked="" type="checkbox"/> specify <u>Somers Water Supply</u>		12. WELL LOG	
5. TYPE OF WORK: New well <input checked="" type="checkbox"/> Method: Dug <input type="checkbox"/> Bored <input checked="" type="checkbox"/> Deepened <input type="checkbox"/> Cable <input type="checkbox"/> Driven <input type="checkbox"/> Reconditioned <input type="checkbox"/> Rotary <input checked="" type="checkbox"/> Jetted <input type="checkbox"/>		Depth (ft.) From To Formation	
6. DIMENSIONS: Diameter of Hole Dia. <u>17 1/2</u> in. from <u>0</u> ft. to <u>213</u> ft. Dia. <u>10</u> in. from <u>213</u> ft. to <u>362</u> ft. Dia. _____ in. from _____ ft. to _____ ft.		0 9 Bricks, sawdust & metal mixed in gravel, broken rock & clay matrix. 9 10 Tan clay. 10 24 Wet sandy tan clay. 24 31 Broken gray rock with clay seams. 15 to 30 GPM dirty water. 31 42 Broken greenish-gray rock. 42 46 Hard dark gray rock. 46 51 Fractured dark gray rock with calcite seams. 5 to 10 GPM water. 51 73 Hard dark gray rock. 73 80 Fractured gray rock with orange clay in fractures. 5 to 10 GPM silty, dirty water. 80 94 Hard light gray rock. 94 96 Clay or gouge filled fractures. 96 104 Hard dark gray rock. 104 118 Fractured dark gray rock with tan to brown clay or gouge in fractures. 118 121 Fractured dark gray rock with brown clay or gouge in fractures. 121 129 Dark gray rock. 129 148 Broken dirty gray rock with soft white clay seams or gouge. 148 170 Dark gray rock. 170 181 Fractured dark green rock with streaks of calcite. 20 to 25 GPM dirty water. 181 187 Hard greenish-gray rock. 187 212 Badly fractured green rock with gray clay or gouge. 50 to 75 GPM dirty water. 212 219 Hard green rock. 219 237 Fractured green rock with soft white & brown clay or gouge in fractures. 40 to 50 GPM dirty water. **Continued on Page 2**	
7. CONSTRUCTION DETAILS: Casing; Steel Dia. <u>12 3/4</u> from <u>+5</u> ft. to <u>213</u> ft. Threaded <input type="checkbox"/> Welded <input checked="" type="checkbox"/> Dia. <u>8 5/8</u> from <u>211</u> ft. to <u>362</u> ft. Type <u>A538</u> Wall Thickness <u>.375/.250</u> Casing; Plastic Dia. _____ from _____ ft. to _____ ft. Weight _____ Dia. _____ from _____ ft. to _____ ft. PERFORATIONS: Yes <input checked="" type="checkbox"/> No <input type="checkbox"/> Type of perforator used <u>Mills Knife</u> Size of perforations <u>1/4</u> in. by <u>2 1/2</u> in. <u>458</u> perforations from <u>237</u> ft. to <u>276</u> ft. <u>60</u> perforations from <u>289</u> ft. to <u>294</u> ft. <u>288</u> perforations from <u>335</u> ft. to <u>359</u> ft. SCREENS: Yes <input type="checkbox"/> No <input checked="" type="checkbox"/> Manufacturer's Name _____ Type _____ Model No. _____ Dia. _____ Slot size _____ from _____ ft. to _____ ft. Dia. _____ Slot size _____ from _____ ft. to _____ ft. GRAVEL PACKED: Yes <input type="checkbox"/> No <input checked="" type="checkbox"/> Size of gravel _____ Gravel placed from _____ ft. to _____ ft. GROUTED: To what depth? <u>213</u> ft. Material used in grouting <u>Cement Grout</u>		13. DATE COMPLETED <u>May 4, 1990</u>	
8. WELL HEAD COMPLETION: Pitless Adapter <input type="checkbox"/> Yes <input checked="" type="checkbox"/> No		14. DRILLER/CONTRACTOR'S CERTIFICATION This well was drilled under my jurisdiction and this report is true to the best of my knowledge. <u>January 26, 1994</u> Date <u>Liberty Drilling & Pump Company, Inc.</u> Firm Name <u>350 Highway 93 South</u> <u>Kalispell, Montana 59901</u> Address <u>William F. Osborne</u> #52 Signature License No.	
9. PUMP (if installed) Manufacturer's name <u>Berkeley</u> Type <u>Subm</u> Model No. <u>7T350</u> HP. <u>30</u>			
10. WELL TEST DATA The information requested in this section is required for all wells. All depth measurements shall be from the top of the well casing. All wells under 100 gpm must be tested for a minimum of one hour and provide the following information: a) Air <u>6 hours</u> Pump <u>32 hours</u> Bailer _____ b) Static water level immediately before testing <u>276</u> ft. If flowing; closed-in pressure _____ psi. _____ gpm. Flow controlled by: _____ valve, _____ reducers, _____ other, (specify) _____ c) Depth at which pump is set for test <u>165'</u> d) The pumping rate: <u>400</u> gpm. e) Pumping water level <u>69'09"</u> ft. at <u>24</u> hrs. after pumping began.			

MONTANA DEPARTMENT OF NATURAL RESOURCES & CONSERVATION
1520 EAST SIXTH AVENUE HELENA, MONTANA 59620-2301 444-6610

DNRC

RECEIVED

JAN 27 1994

MONTANA D.N.R.C.
KALISPELL REGIONAL OFFICE

101-140159

LIBERTY DRILLING & PUMP COMPANY, INC.



3850 Highway 93 South Kalispell, Montana 59901
Ph. (406) 752-2809 Fax (406) 756-0029


January 26, 1994
Somers Water District - Yacht Club Well
State Well Log
Page 2 of 2

- 237 - 276 Fractured greenish-gray rock with calcite and quartz seams. 100+ gallons per minute water.
- 276 - 289 Dark gray rock.
- 289 - 294 Fractured greenish-gray rock with brown clay or gouge in fractures. 60 to 90 gpm water.
- 294 - 305 Greenish-gray rock.
- 305 - 336 Hard dark gray rock.
- 336 - 360 Fractured greenish-gray rock with brown clay or gouge in fractures. 250+ gallons per minute water.
- 360 - 362 Brown clay or gouge.

Note: A cement plug was placed in the bottom of the eight inch casing to prevent clay or gouge at 362' from entering the well.

140159

Appendix G: Tank As-Builts

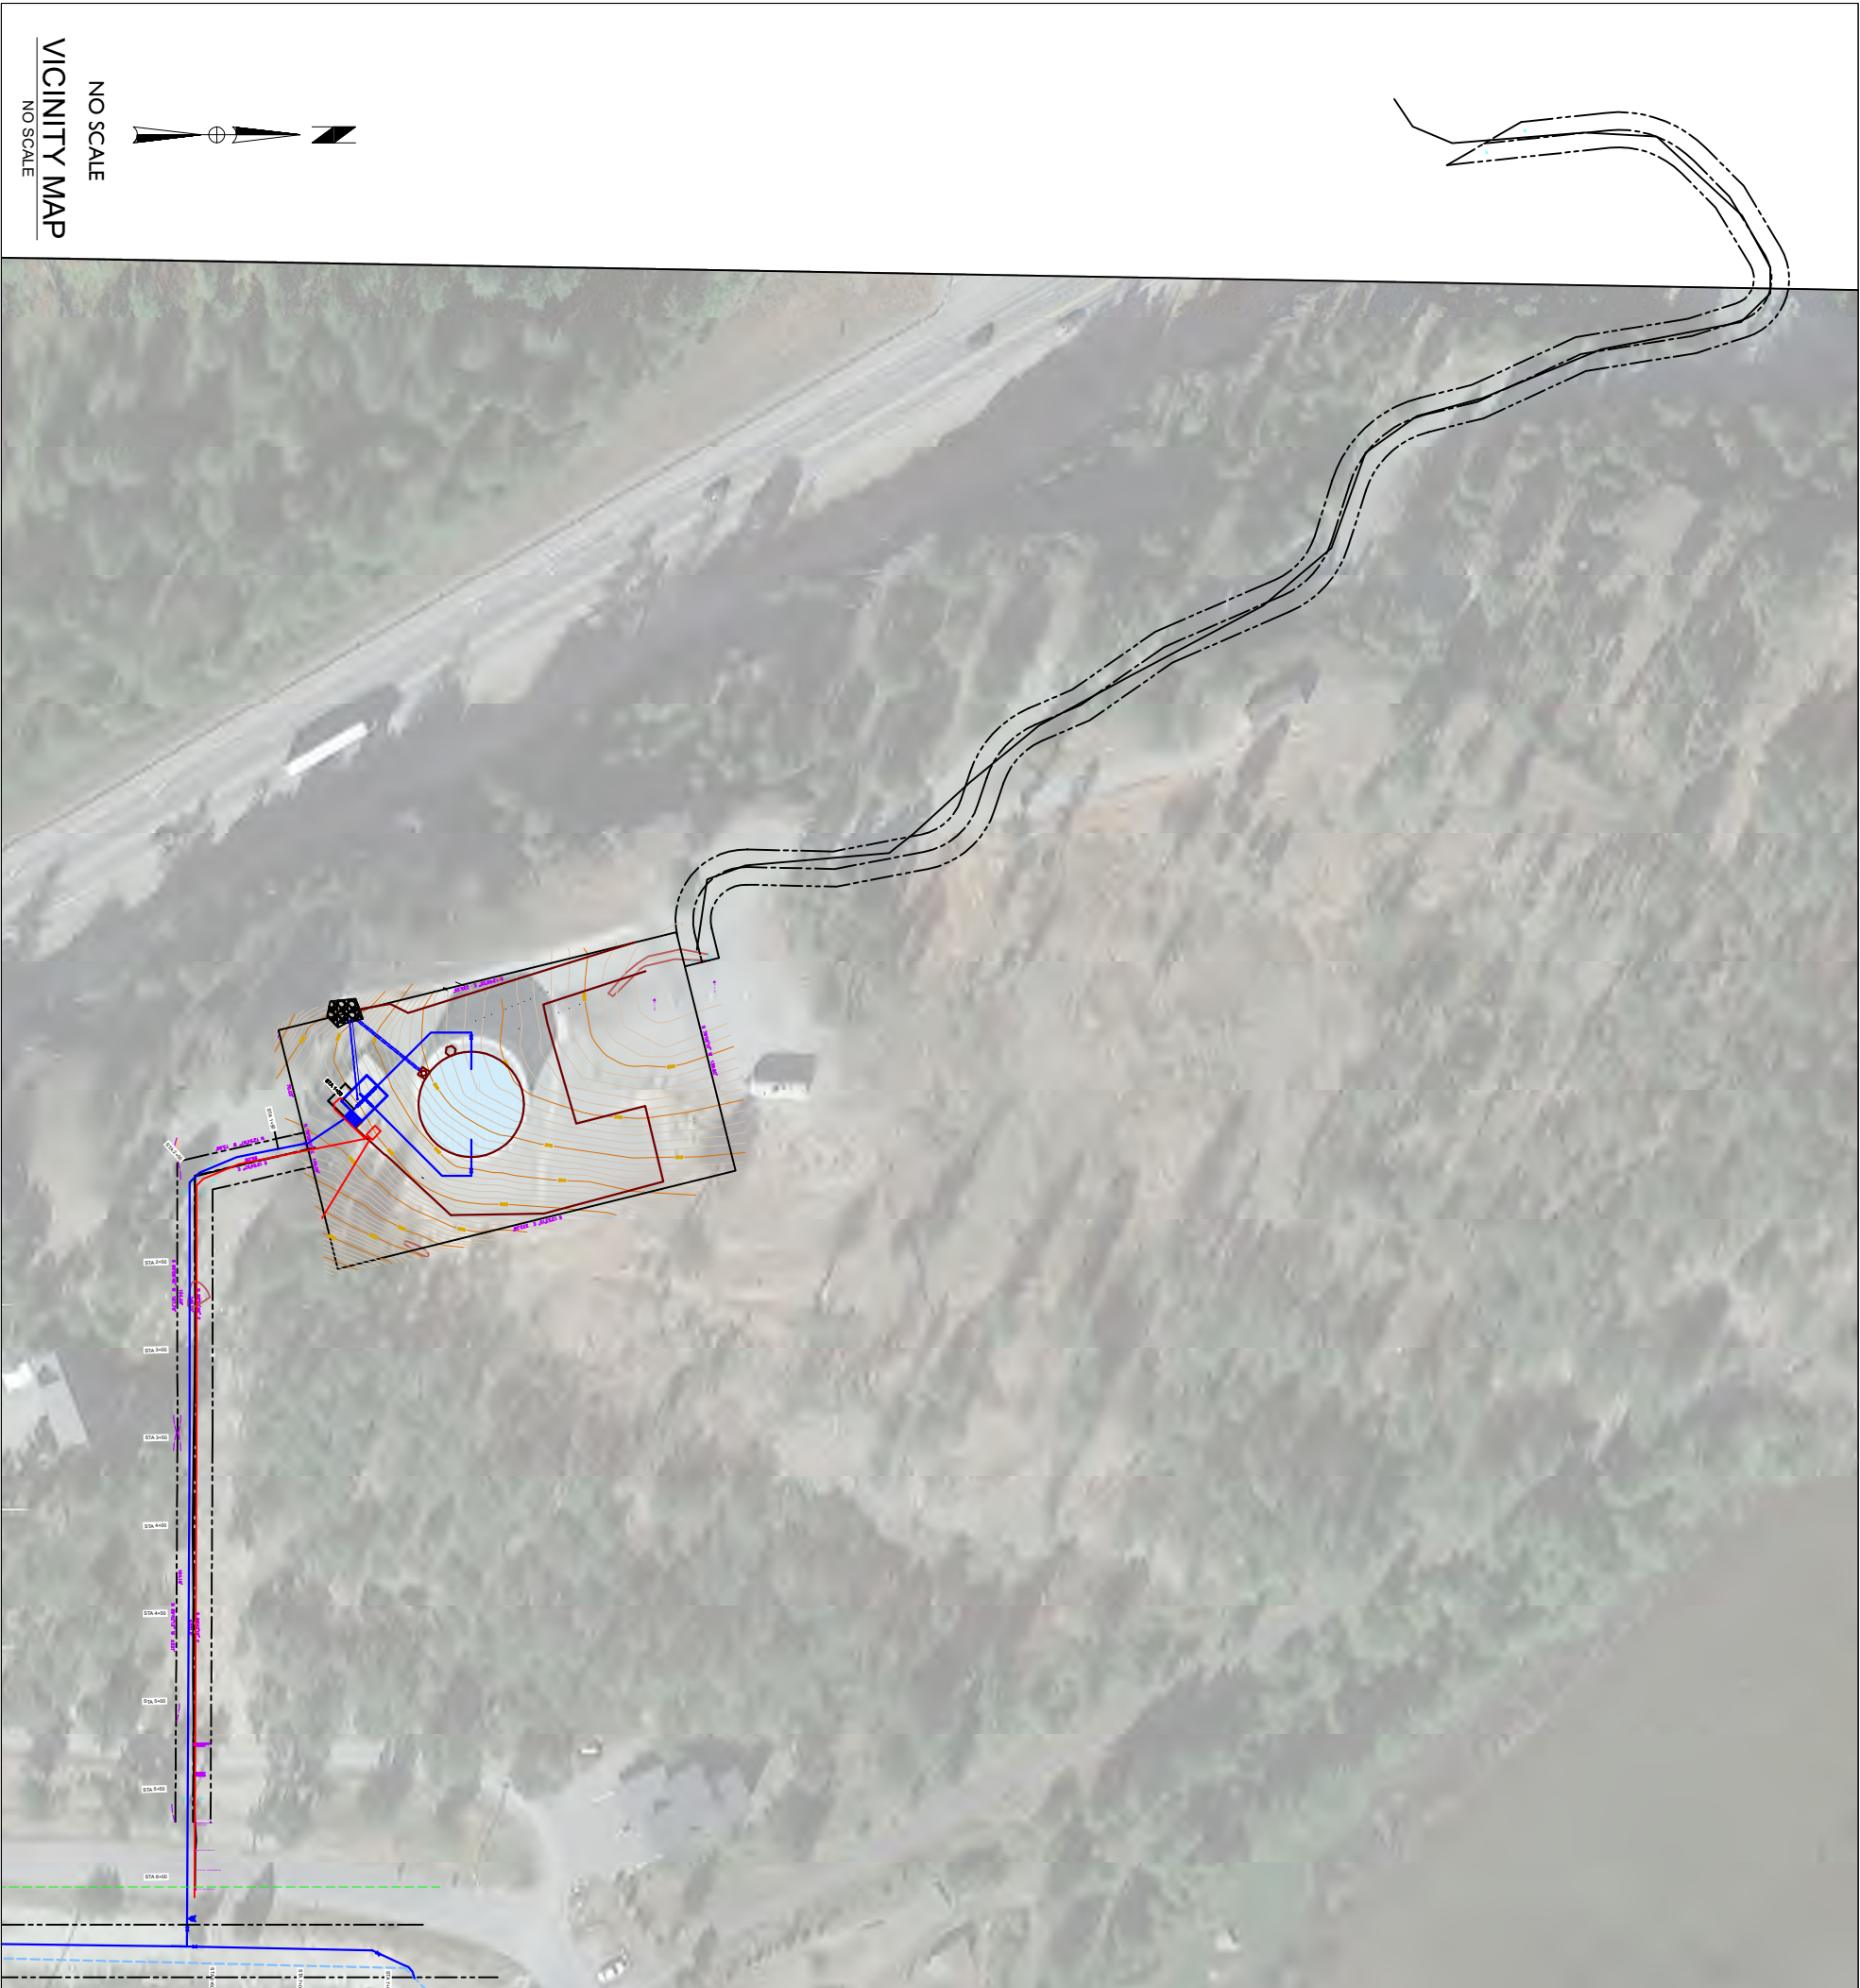

LEGEND:

- CONTROL POINT
- EX. WATER METER
- SANITARY MANHOLE
- EX. WATER VALVE
- PHONE PEDESTAL
- TV PEDESTAL
- POWER POLE
- NEW GATE VALVE
- NEW WATER VALVE
- NEW WATER REDUCER
- NEW FIRE HYDRANT / BLOWOFF
- NEW AIR RELEASE VALVE
- NEW WATER LINE
- EXISTING WATER LINE
- EXISTING SEWER LINE
- OVERHEAD PHONE/CABLE
- OVERHEAD POWER
- OVERHEAD POWER
- NEW EASEMENT
- EXISTING FENCE
- BURIED TELEPHONE
- BURIED FIBER OPTIC
- BURIED TELEPHONE/CABLE


GENERAL NOTES:

- THE CONTRACTOR SHALL NOTIFY ALL UTILITY COMPANIES IN WRITING AND SHALL BE RESPONSIBLE FOR SECURING THE EXACT LOCATION OF ALL EXISTING UNDERGROUND UTILITIES PRIOR TO BEGINNING EXCAVATION.
- CONTRACTOR SHALL COMPLY WITH ALL APPLICABLE REQUIREMENTS OF PERMITS OBTAINED FOR PROJECT CONSTRUCTION.
- THE CONTRACTOR IS RESPONSIBLE FOR PROVIDING ALL MATERIALS, EQUIPMENT, AND LABOR FOR A COMPLETE FUNCTIONING PROJECT
- THE CONTRACTOR IS RESPONSIBLE FOR PROTECTING, REPLACING, OR REPAIRING EXISTING UTILITIES (DRY & WET)
- ALL WORK SHALL BE IN COMPLIANCE WITH MONTANA PUBLIC WORK STANDARD SPECIFICATIONS (MPWSS), 6TH EDITION, DEQ, AMWA, OSHA, & ALL RELEVANT LOCAL, STATE, & FEDERAL REGULATIONS.
- EXISTING UTILITIES SHOWN ARE TO BEST KNOWLEDGE AVAILABLE. UTILITIES NOT SHOWN DO NOT ALLEVATE CONTRACTOR FROM CONTRACT PROVISIONS. NO ADDITIONAL PAYMENTS WILL BE MADE FOR NON-DISCLOSED, UNDISCOVERED, OR UNKNOWN UTILITIES OR SERVICES
- CONTRACTOR TO COORDINATE WITH NW ENERGY & FLATHEAD ELECTRIC PRIOR & DURING CONSTRUCTION. ANY BLASTING MUST BE COORDINATED WITH CONTRACT SPECIFICATIONS & UTILITY MONITORING REQUIREMENTS.
- ENTIRE PROJECT IS SUBJECT TO CURRENT AMERICAN IRON & STEEL REQUIREMENTS, INCLUDING NUTS AND BOLTS. THE PREVIOUS NUT & BOLT WAIVER HAS EXPIRED.

WATER NOTES:




- PLANS INDICATE EXISTING PIPES TYPES & SIZE. BUT ACCURACY IS UNKNOWN. CONTRACTOR TO FIELD VERIFY ALL PIPE TYPE SIZES & LOCATIONS WHERE NECESSARY TO SUCCESSFULLY COMPLETE CONTRACT WORK. NO ADDITIONAL PAYMENTS WILL BE MADE FOR NON-DISCLOSED, UNDISCOVERED, OR UNKNOWN UTILITIES OR SERVICES.
- MEGALUGS (OR APPROVED EQUAL) TO BE USED WITH MECHANICAL JOINTS & THRUST BLOCKS TO BE IN ACCORDANCE WITH MPWSS.
- PIPE AND PIPE FITTINGS CONTAINING MORE THAN 0.25 PERCENT LEAD MUST NOT BE USED. ALL PRODUCTS MUST COMPLY WITH ANSI/NSF STANDARDS.
- SOLDERS AND FLUX CONTAINING MORE THAN 0.2 PERCENT LEAD AND PIPE FITTINGS CONTAINING MORE THAN 0.25 PERCENT LEAD MUST NO BE USED ON SERVICE CONNECTIONS.

NO SCALE
VICINITY MAP
NO SCALE

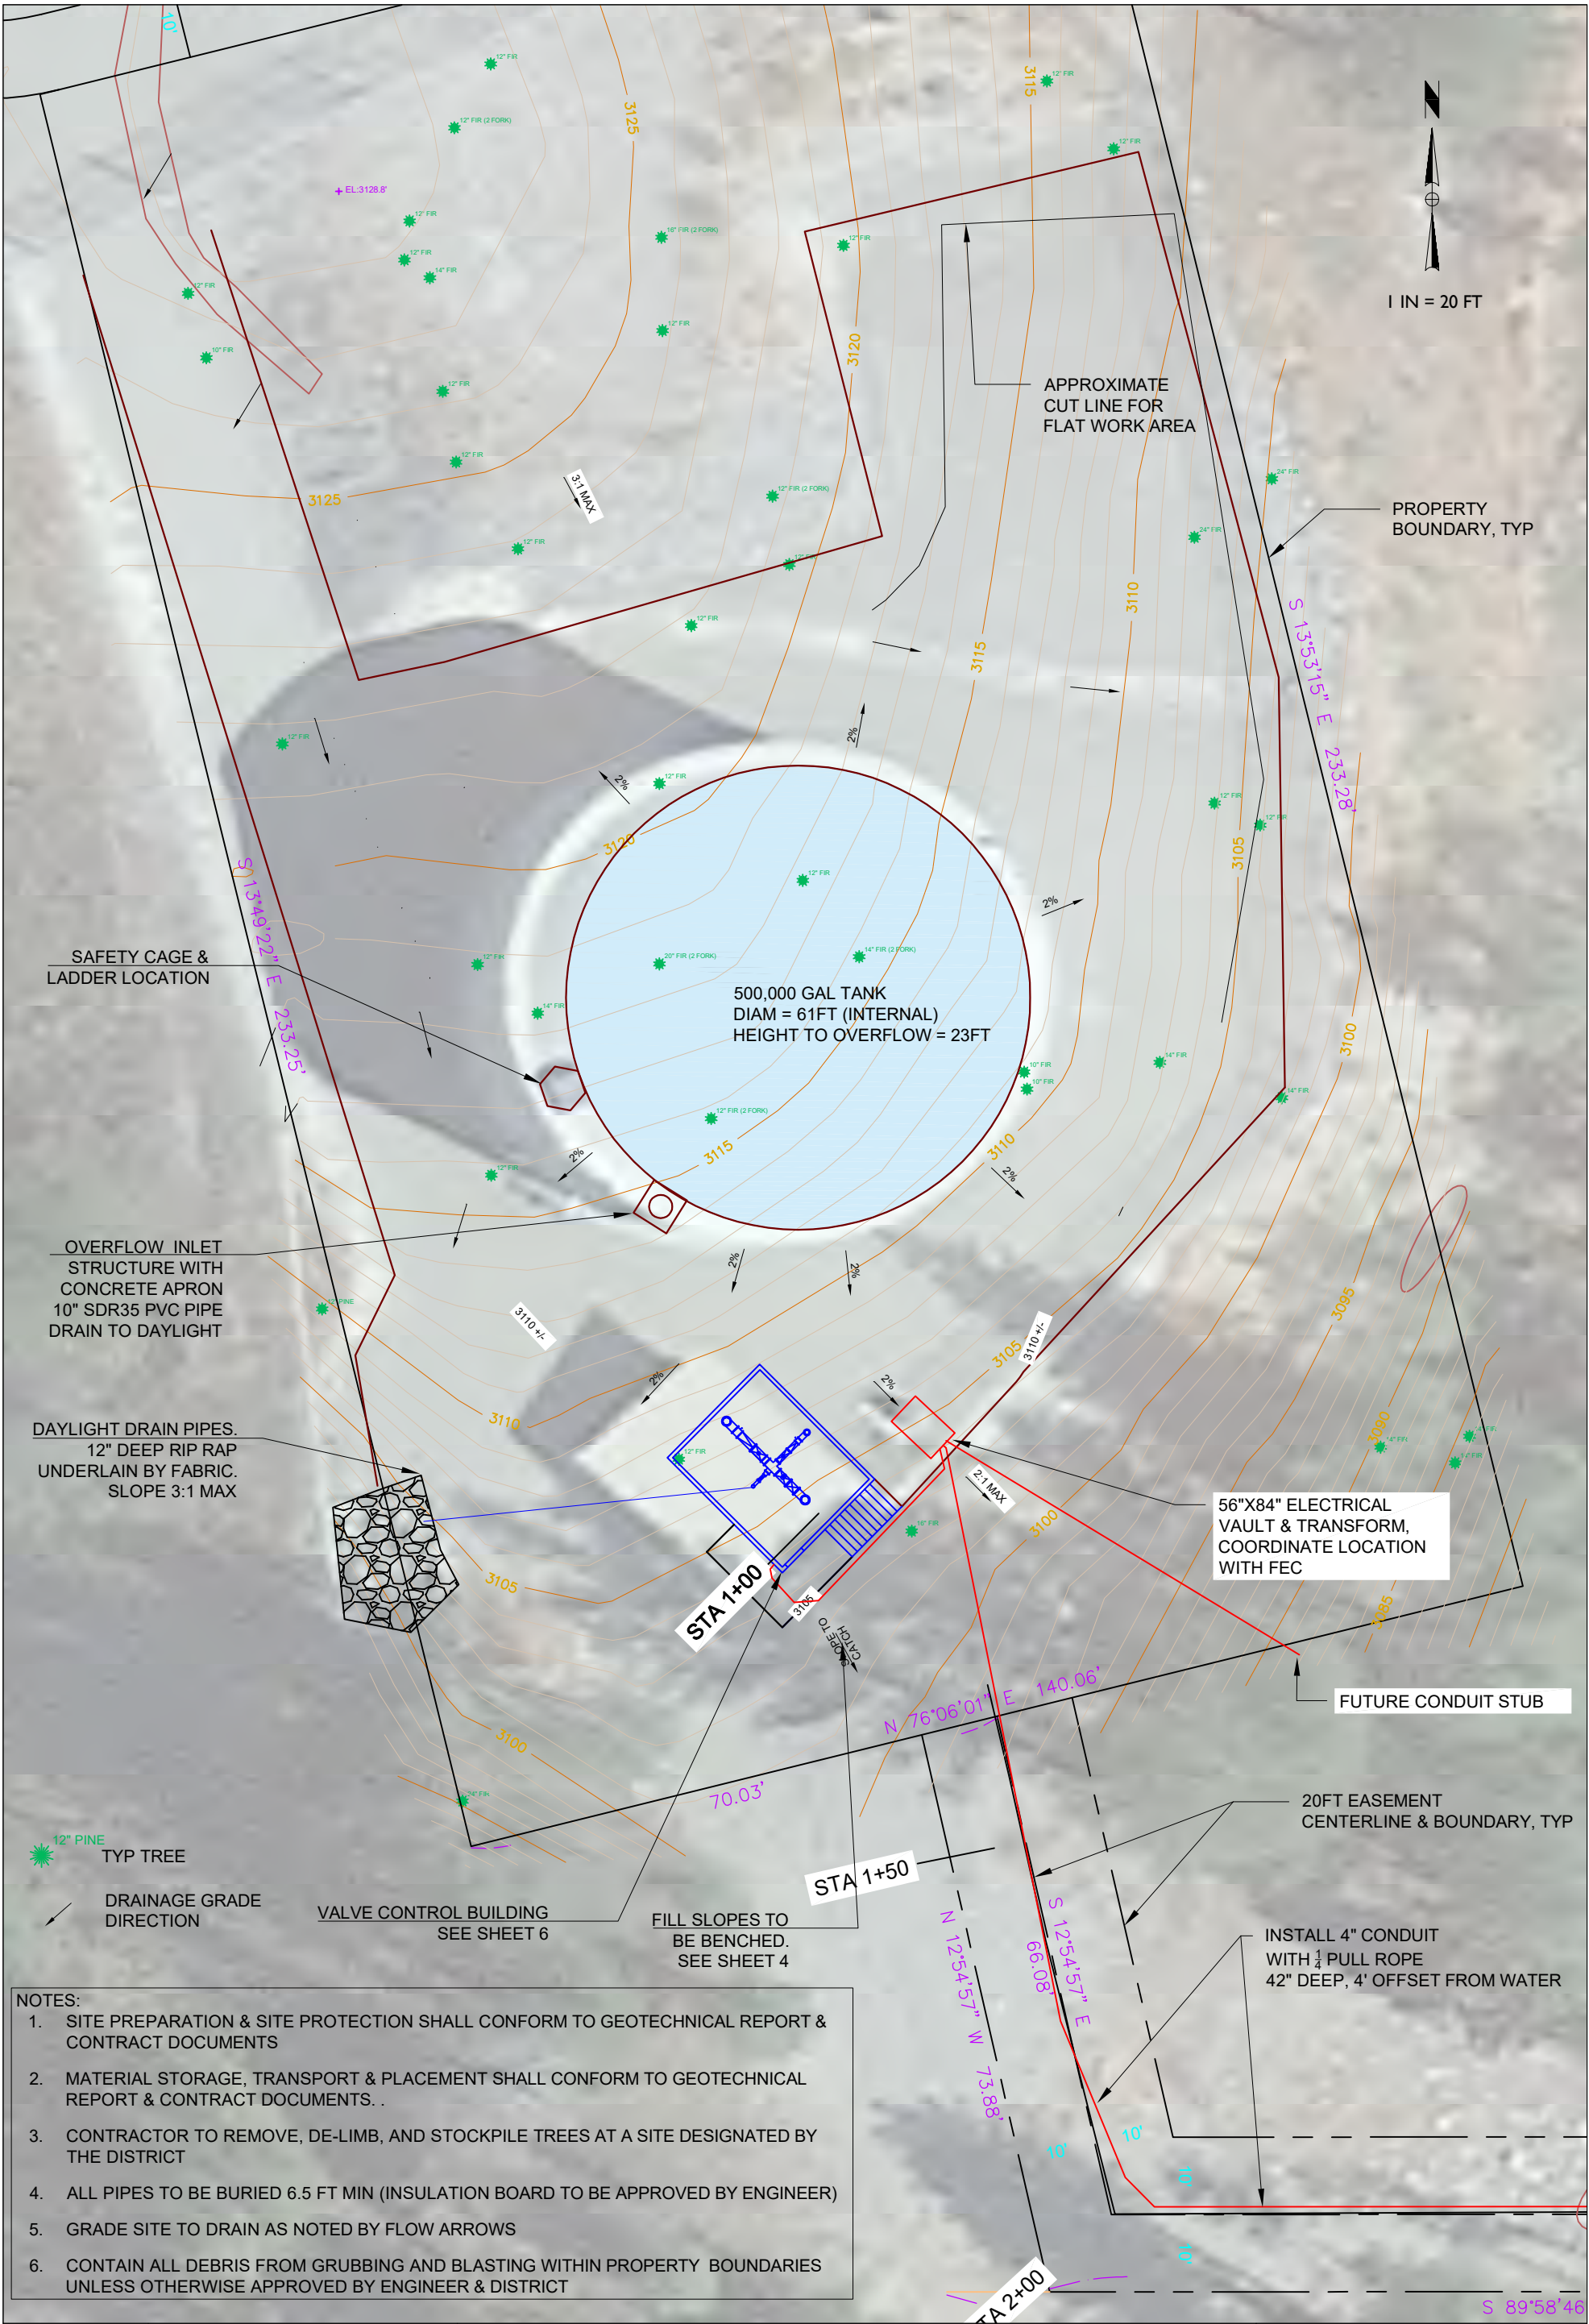

- NOTES:
1. SITE PREPARATION & SITE PROTECTION SHALL CONFORM TO GEOTECHNICAL REPORT & CONTRACT DOCUMENTS
 2. MATERIAL STORAGE, TRANSPORT & PLACEMENT SHALL CONFORM TO GEOTECHNICAL REPORT & CONTRACT DOCUMENTS. .
 3. CONTRACTOR TO REMOVE, DE-LIMB, AND STOCKPILE TREES AT A SITE DESIGNATED BY THE DISTRICT
 4. ALL PIPES TO BE BURIED 6.5 FT MIN (INSULATION BOARD TO BE APPROVED BY ENGINEER)
 5. GRADE SITE TO DRAIN AS NOTED BY FLOW ARROWS
 6. CONTAIN ALL DEBRIS FROM GRUBBING AND BLASTING WITHIN PROPERTY BOUNDARIES UNLESS OTHERWISE APPROVED BY ENGINEER & DISTRICT


of 10	Sheet Number: 3	SHARI A JOHNSON & ASSOCIATES ENGINEERING PLLC	SOMERS NEW WATER TANK IMPROVEMENTS SOMERS WATER & SEWER DISTRICT, MONTANA	Date Designed <u>SAJ</u> <u>2/11/20</u> Revisions <u>SAJ 11/7/20</u> <u>ASBUILT 3/30/23</u>	
		Engineering@SAJmontana.com 406-261-3019		TANK SITE & GRADING	SURVEY PREPARED BY: WILLIAM BRECKENRIDGE, PLS

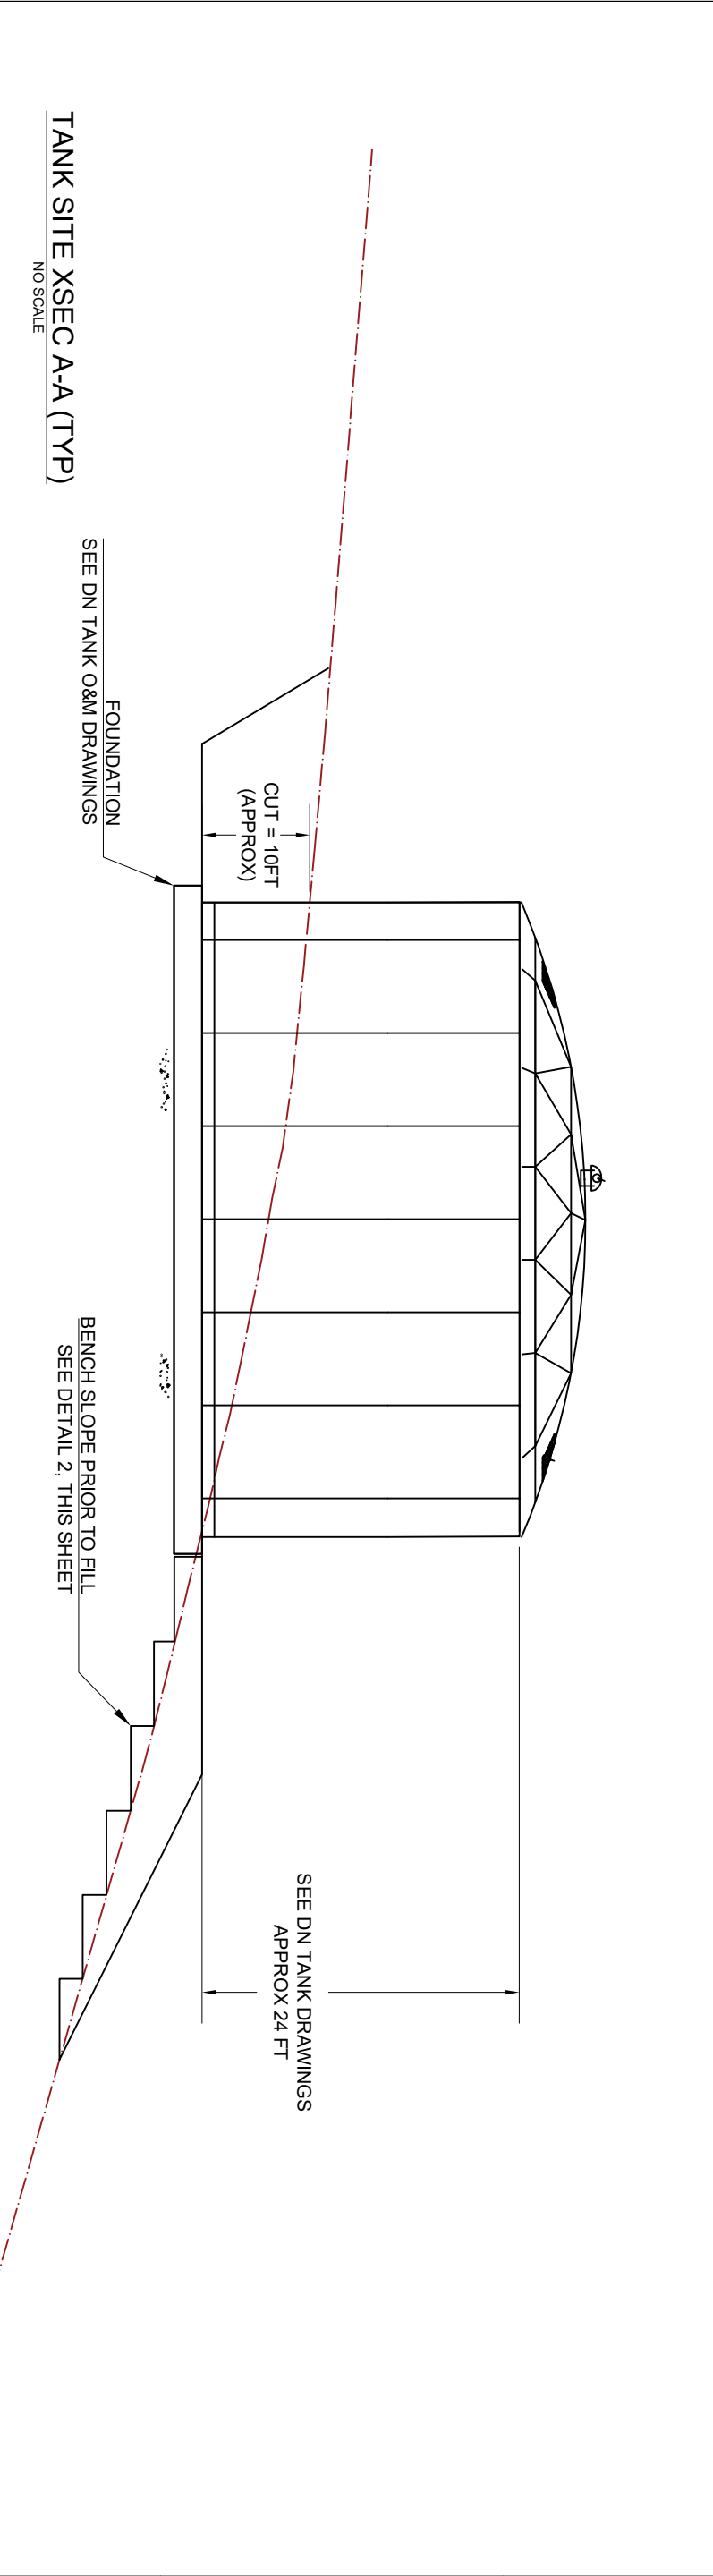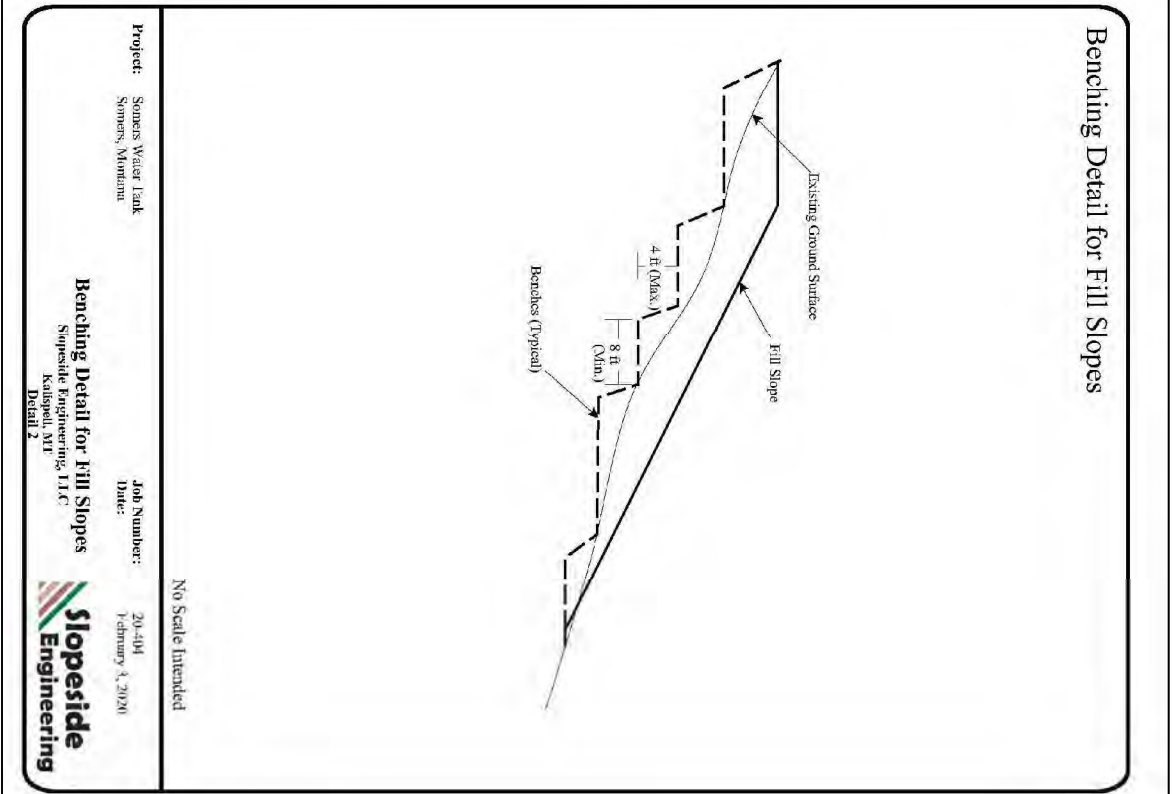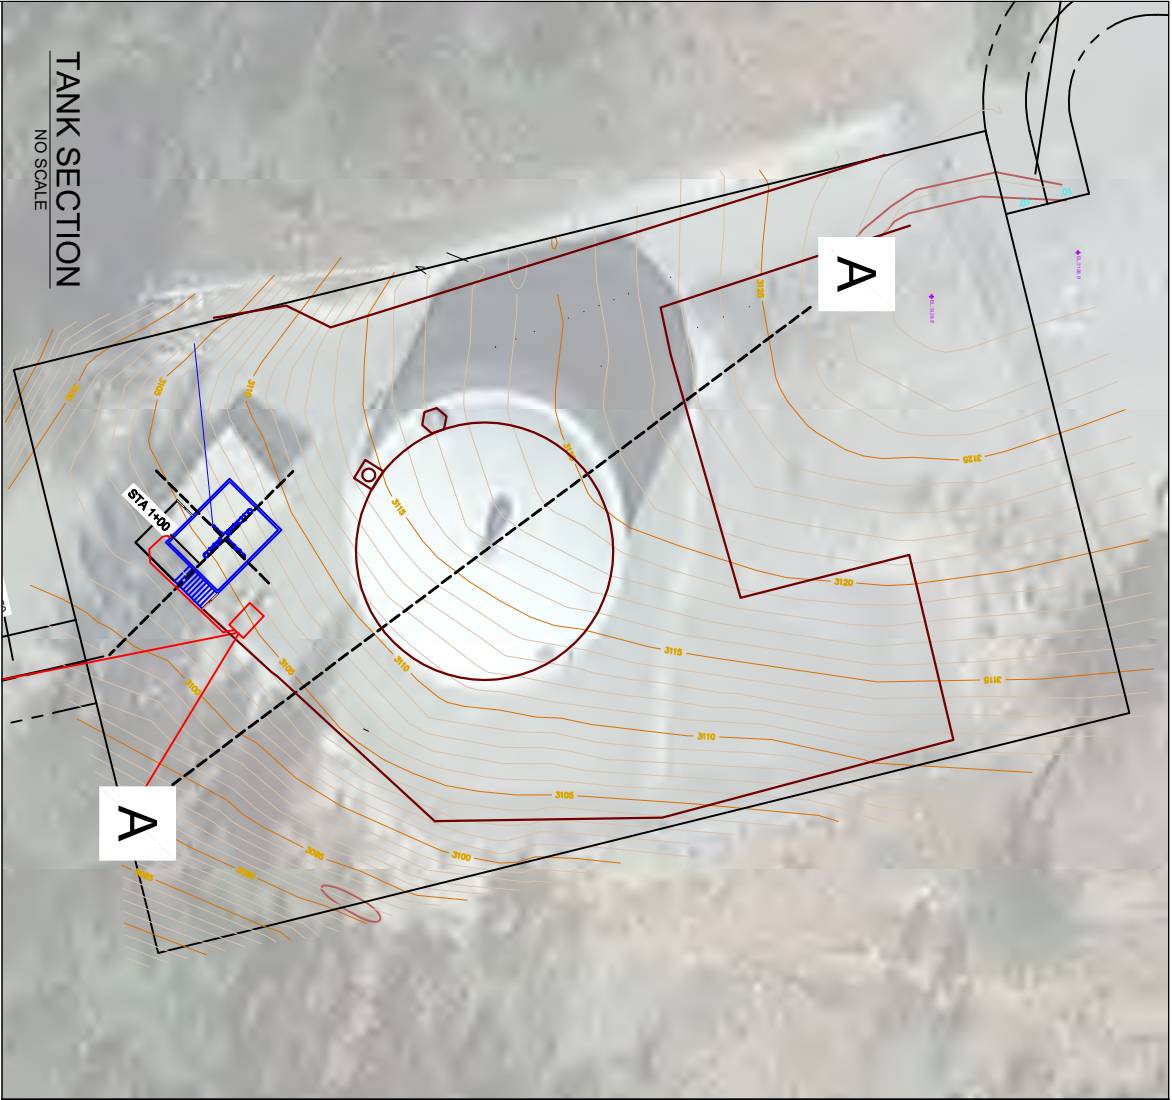

of 10	4	Sheet Number:	SHARI A JOHNSON & ASSOCIATES ENGINEERING PLLC	SOMERS NEW WATER TANK IMPROVEMENTS SOMERS WATER & SEWER DISTRICT, MONTANA	Date Designed: SAJ _____ 2/11/20 Revisions: SAJ 11/7/20 ASBUILT 3/30/23
			Engineering@SAJmontana.com 406-261-3019		TANK PROFILE



4.1	Sheet Number: of 10	SHARI A JOHNSON & ASSOCIATES ENGINEERING PLLC		SOMERS NEW WATER TANK IMPROVEMENTS SOMERS WATER & SEWER DISTRICT, MONTANA		Date Designed <u>SAJ</u> 2/11/20	
		Engineering@SAJmontana.com 406-261-3019		TANK MILESTONES (SEE PHOTO FILE)		Revisions <u>SAJ 11/7/20</u> ASBUILT 3/30/23	
						SURVEY PREPARED BY: WILLIAM BRECKENRIDGE, PLS	

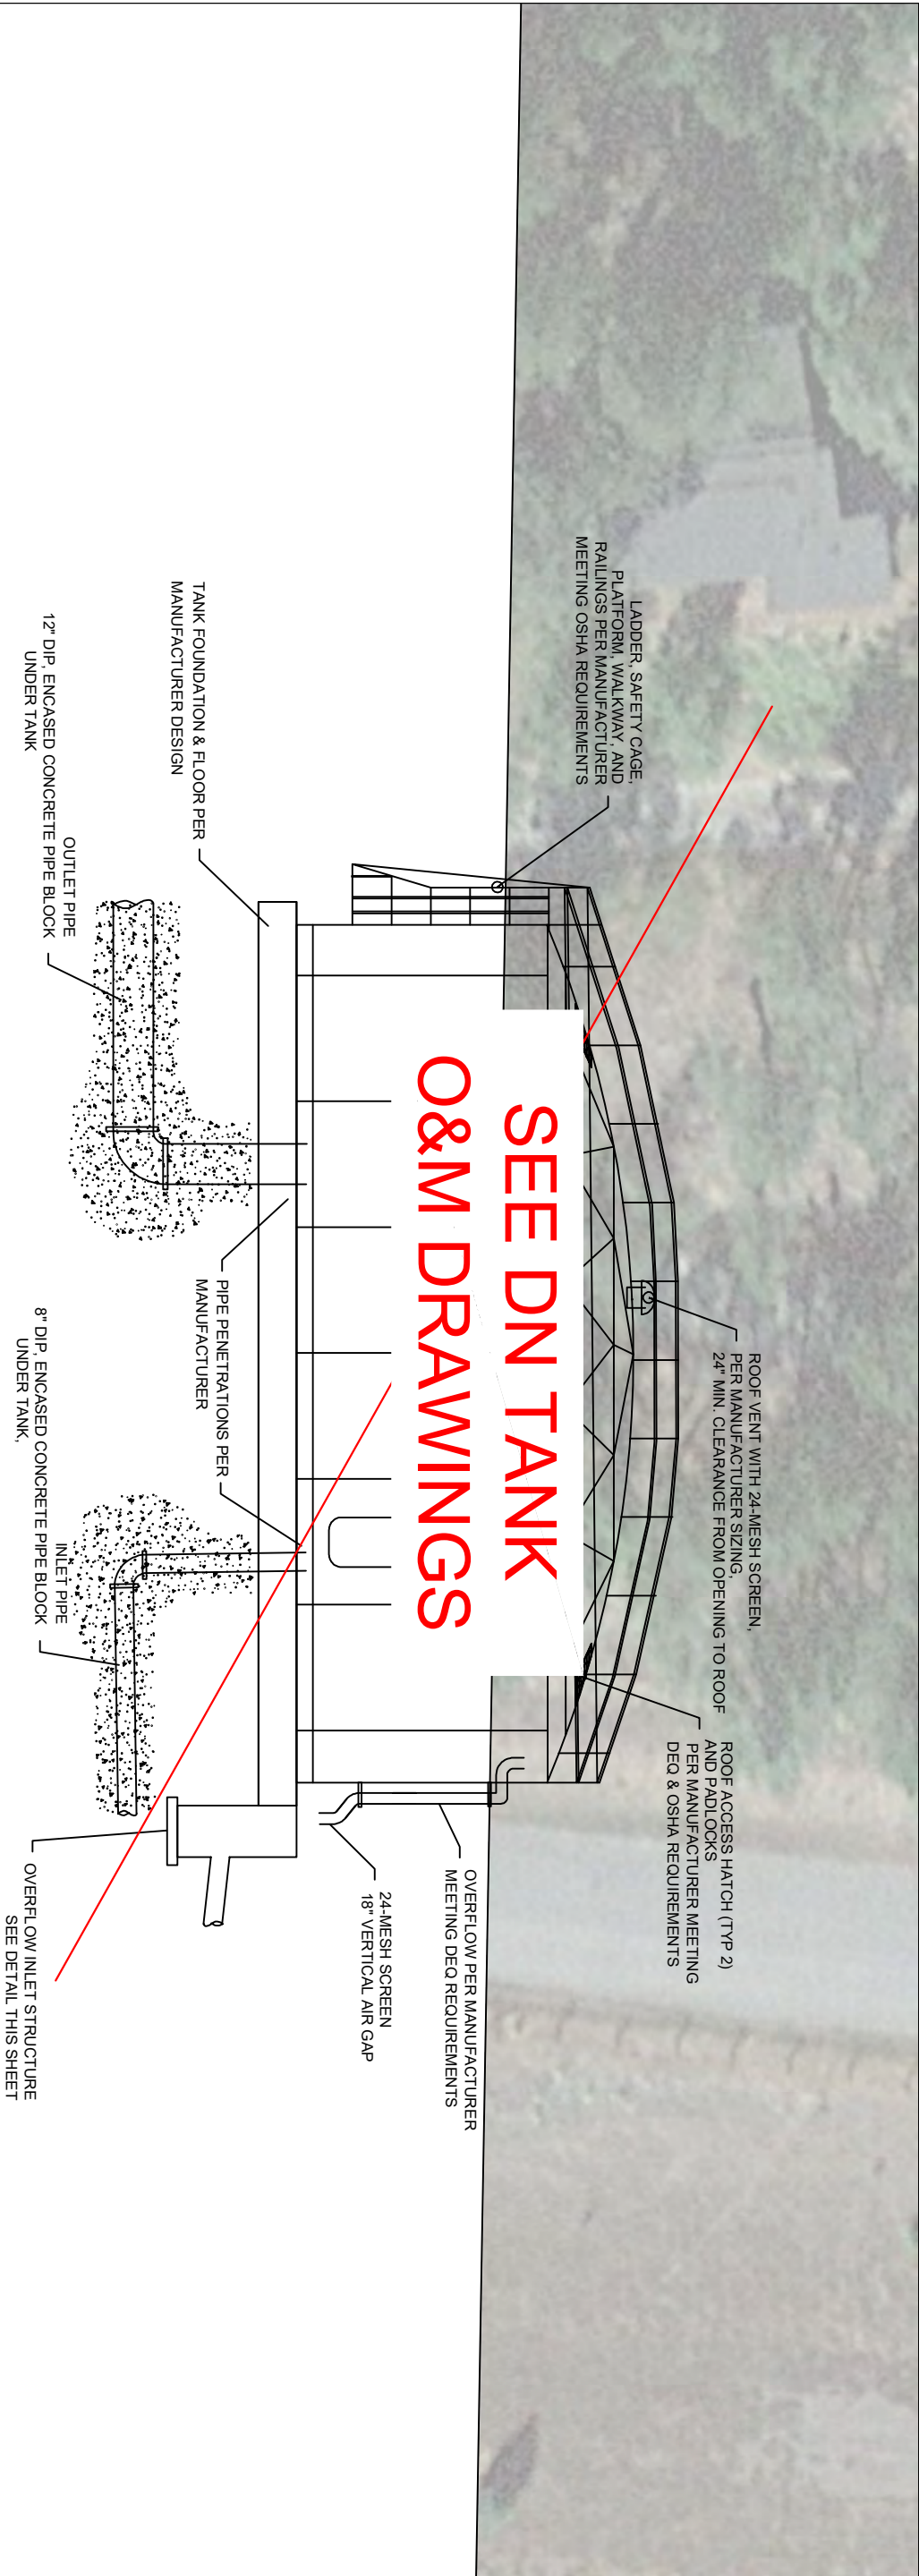


STORAGE TANK TYPICAL SECTION
NO SCALE

- NOTES:
1. PIPING AND TANK APPURTENANCES ARE SHOWN FOR ILLUSTRATIVE CAPACITY ONLY. APPROXIMATE ORIENTATION IS AS FOLLOWS (EXACT POSITIONING TO BE DETERMINED BY SHOP DRAWINGS)
- 0 DEG
90 DEG
180 DEG
150 DEG

NORTH
INLET IN
HATCH DOOR
LADDER CAGE

SEE DN TANK
O&M DRAWINGS

- 2.
- 3.
4. TANK FLOOR PER MANUFACTURERS REQUIREMENTS AND ENGINEER APPROVAL AS TO TYPE.
5. TANK FOUNDATION BY TANK MANUFACTURER'S REQUIREMENTS, TO BE DESIGNED BY LICENSED MONTANA STRUCTURAL ENGINEER
6. 2-INCH MINIMUM SILT STOP AROUND OUTLET, PER MANUFACTURER

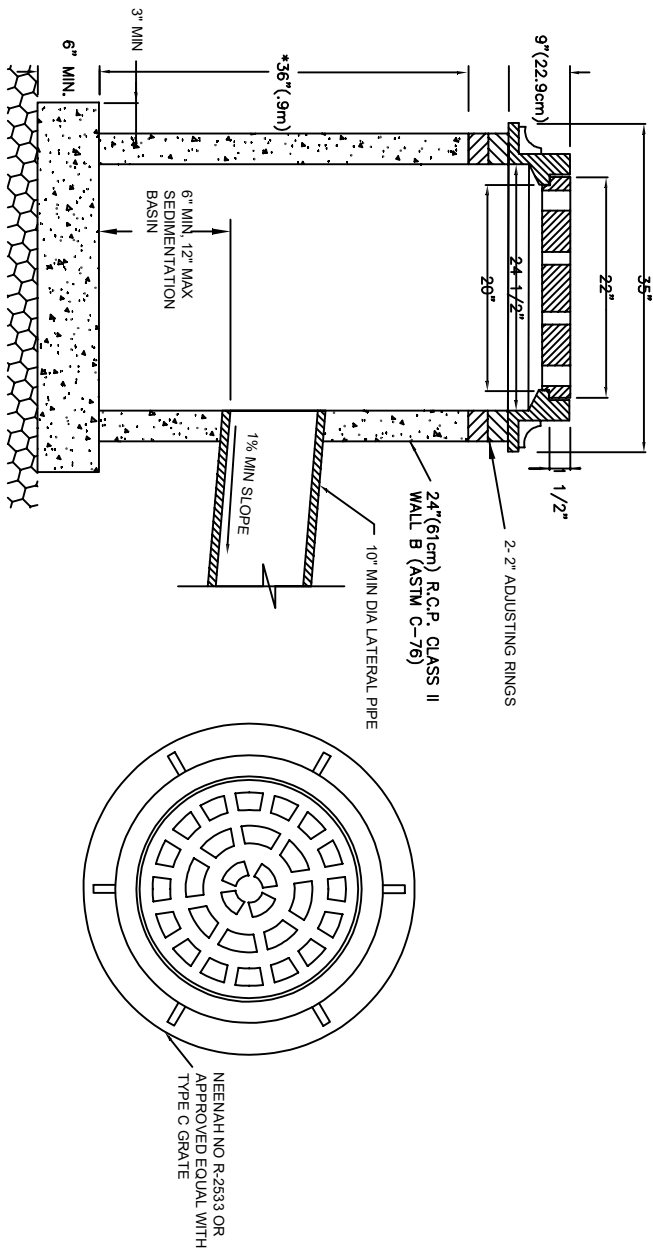

OVERFLOW INLET DETAIL
NO SCALE

Date	
Designed	SAJ 2/11/20
Revisions	SAJ 11/7/20 ASBUILT 3/30/23

SURVEY PREPARED BY:
WILLIAM BRECKENRIDGE, PLS

SOMERS NEW WATER TANK IMPROVEMENTS
SOMERS WATER & SEWER DISTRICT, MONTANA

TANK PROFILE


SHARI A JOHNSON &
ASSOCIATES ENGINEERING
PLLC

Engineering@SAJmontana.com
406-261-3019



Sheet Number:

5

of 10

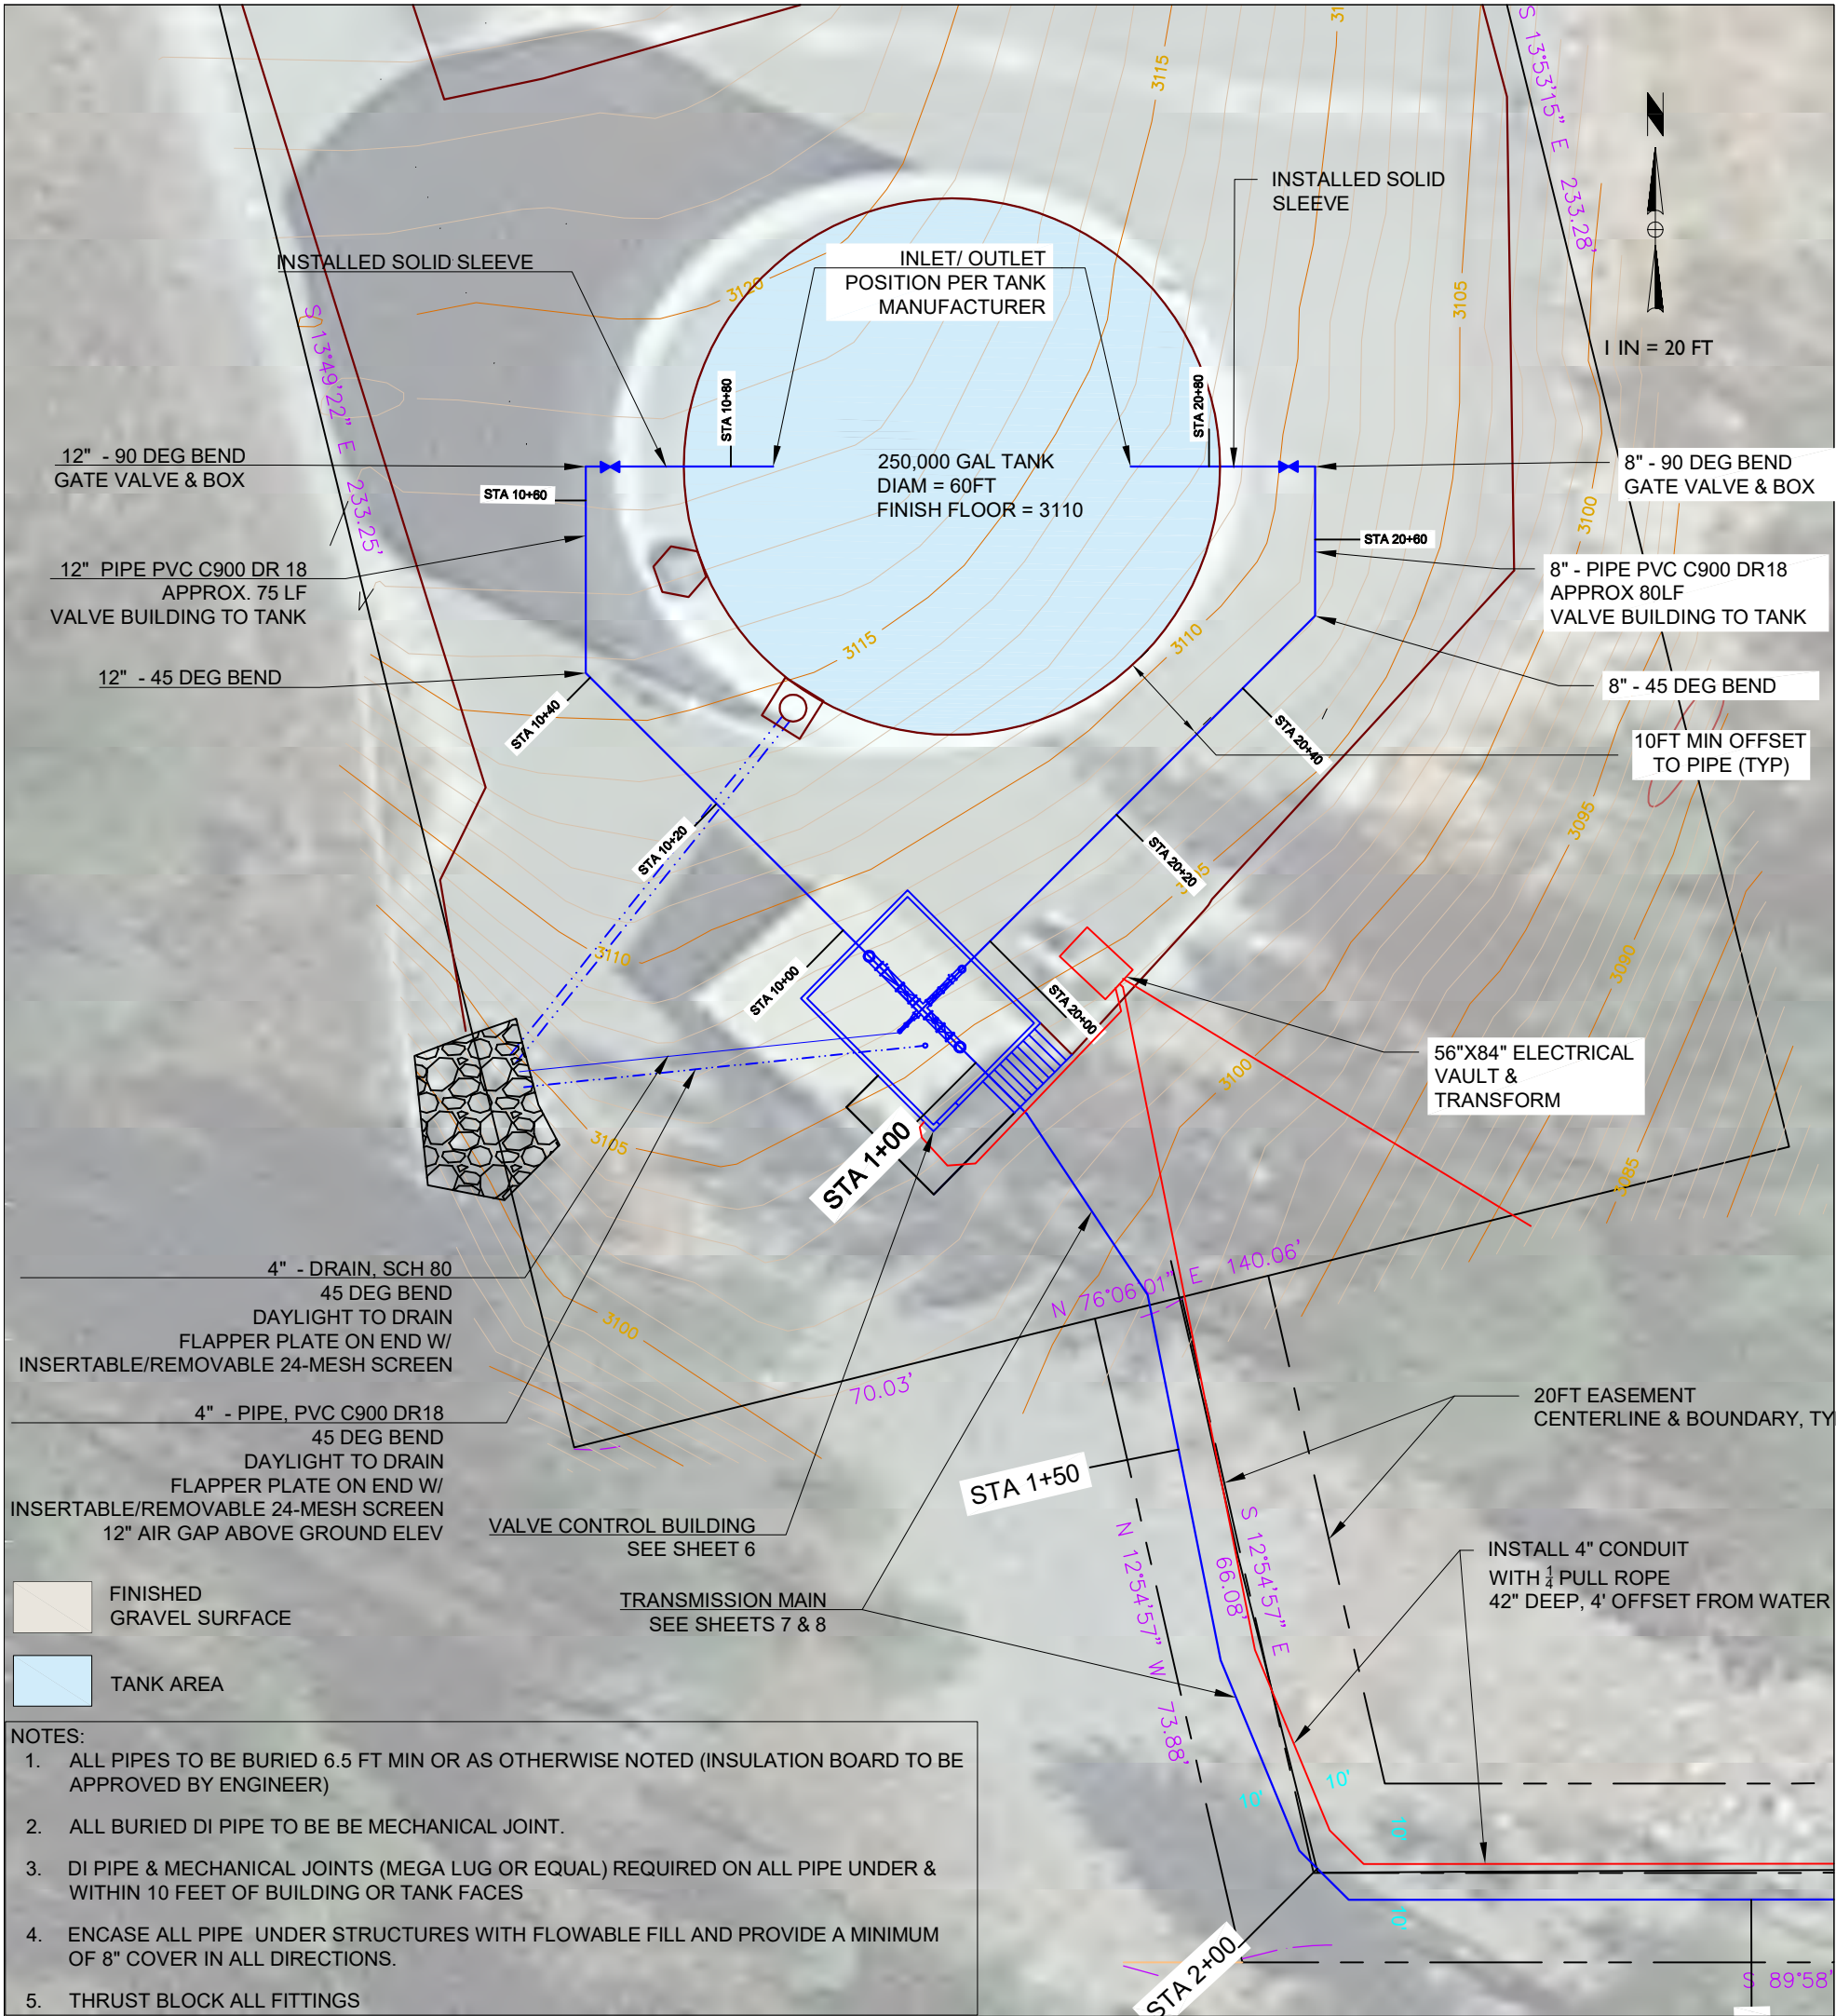

- NOTES:
1. ALL PIPES TO BE BURIED 6.5 FT MIN OR AS OTHERWISE NOTED (INSULATION BOARD TO BE APPROVED BY ENGINEER)
 2. ALL BURIED DI PIPE TO BE MECHANICAL JOINT.
 3. DI PIPE & MECHANICAL JOINTS (MEGA LUG OR EQUAL) REQUIRED ON ALL PIPE UNDER & WITHIN 10 FEET OF BUILDING OR TANK FACES
 4. ENCASE ALL PIPE UNDER STRUCTURES WITH FLOWABLE FILL AND PROVIDE A MINIMUM OF 8" COVER IN ALL DIRECTIONS.
 5. THRUST BLOCK ALL FITTINGS

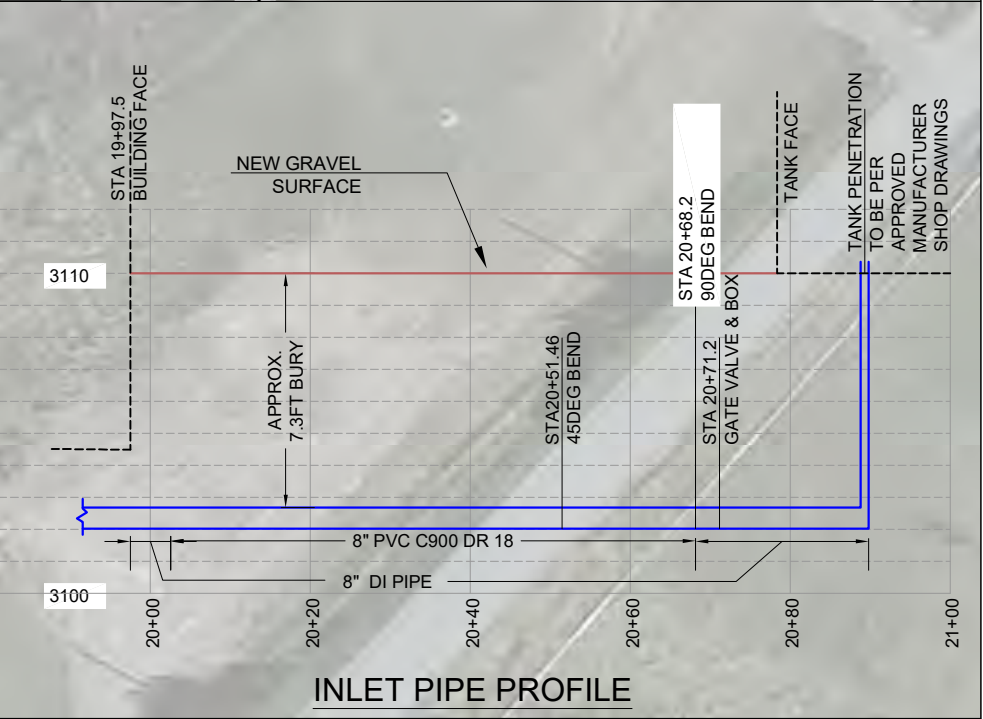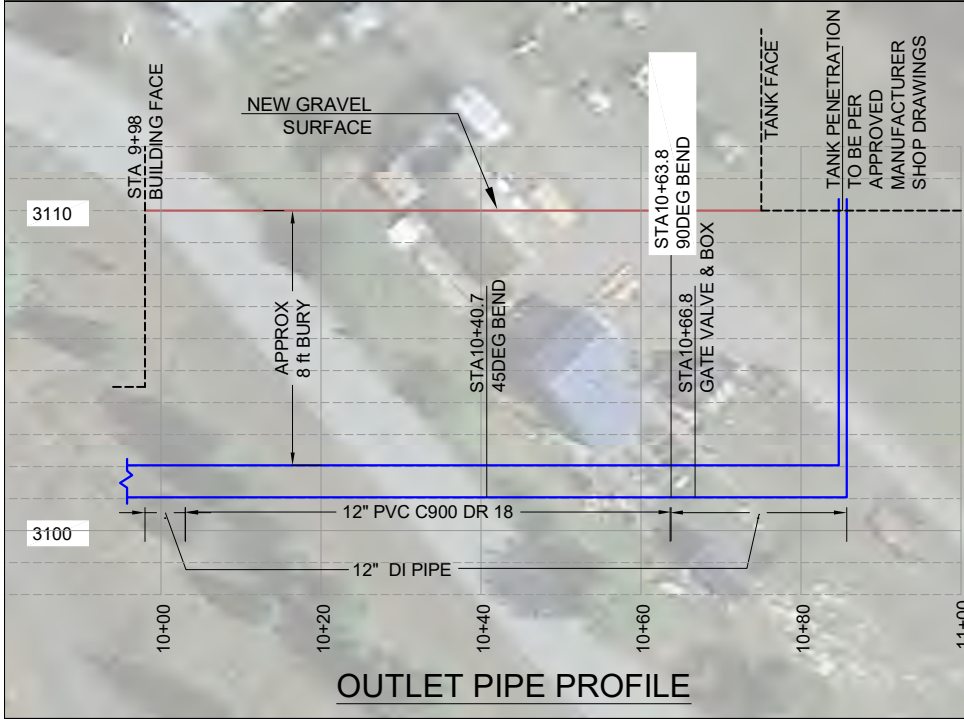

9	Sheet Number:	SHARI A JOHNSON & ASSOCIATES ENGINEERING PLLC	SOMERS NEW WATER TANK IMPROVEMENTS SOMERS WATER & SEWER DISTRICT, MONTANA	TANK PIPE PROFILE	Date Designed <u>SAJ</u> 2/11/20 Revisions <u>SAJ 11/7/20</u> ASBUILT 3/30/23
		Engineering@SAJmontana.com 406-261-3019			
					SURVEY PREPARED BY: WILLIAM BRECKENRIDGE, PLS



OUTLET PIPE PROFILE

INLET PIPE PROFILE

6.1	Sheet Number:	SHARI A JOHNSON & ASSOCIATES ENGINEERING PLLC		SOMERS NEW WATER TANK IMPROVEMENTS SOMERS WATER & SEWER DISTRICT, MONTANA		Date Designed <u>SAJ</u> 2/11/20	
		Engineering@SAJmontana.com 406-261-3019		TANK PIPE (SEE PHOTO FILE)		Revisions <u>SAJ 11/7/20</u> ASBUILT 3/30/23	
						SURVEY PREPARED BY: WILLIAM BRECKENRIDGE, PLS	



TANK OVERFLOW BASIN/PIPE




VALVE HOUSE TANK DRAIN & FLOOR DRAIN



VALVE HOUSE DRAINS TO RIP RAP

6.2 of 10	Sheet Number:	SHARI A JOHNSON & ASSOCIATES ENGINEERING PLLC	SOMERS NEW WATER TANK IMPROVEMENTS SOMERS WATER & SEWER DISTRICT, MONTANA	Date Designed <u>SAJ</u> 2/11/20 Revisions <u>SAJ 11/7/20</u> <u>ASBUILT 3/30/23</u>	
		Engineering@SAJmontana.com 406-261-3019		SURVEY PREPARED BY: WILLIAM BRECKENRIDGE, PLS	
			DRAINS		

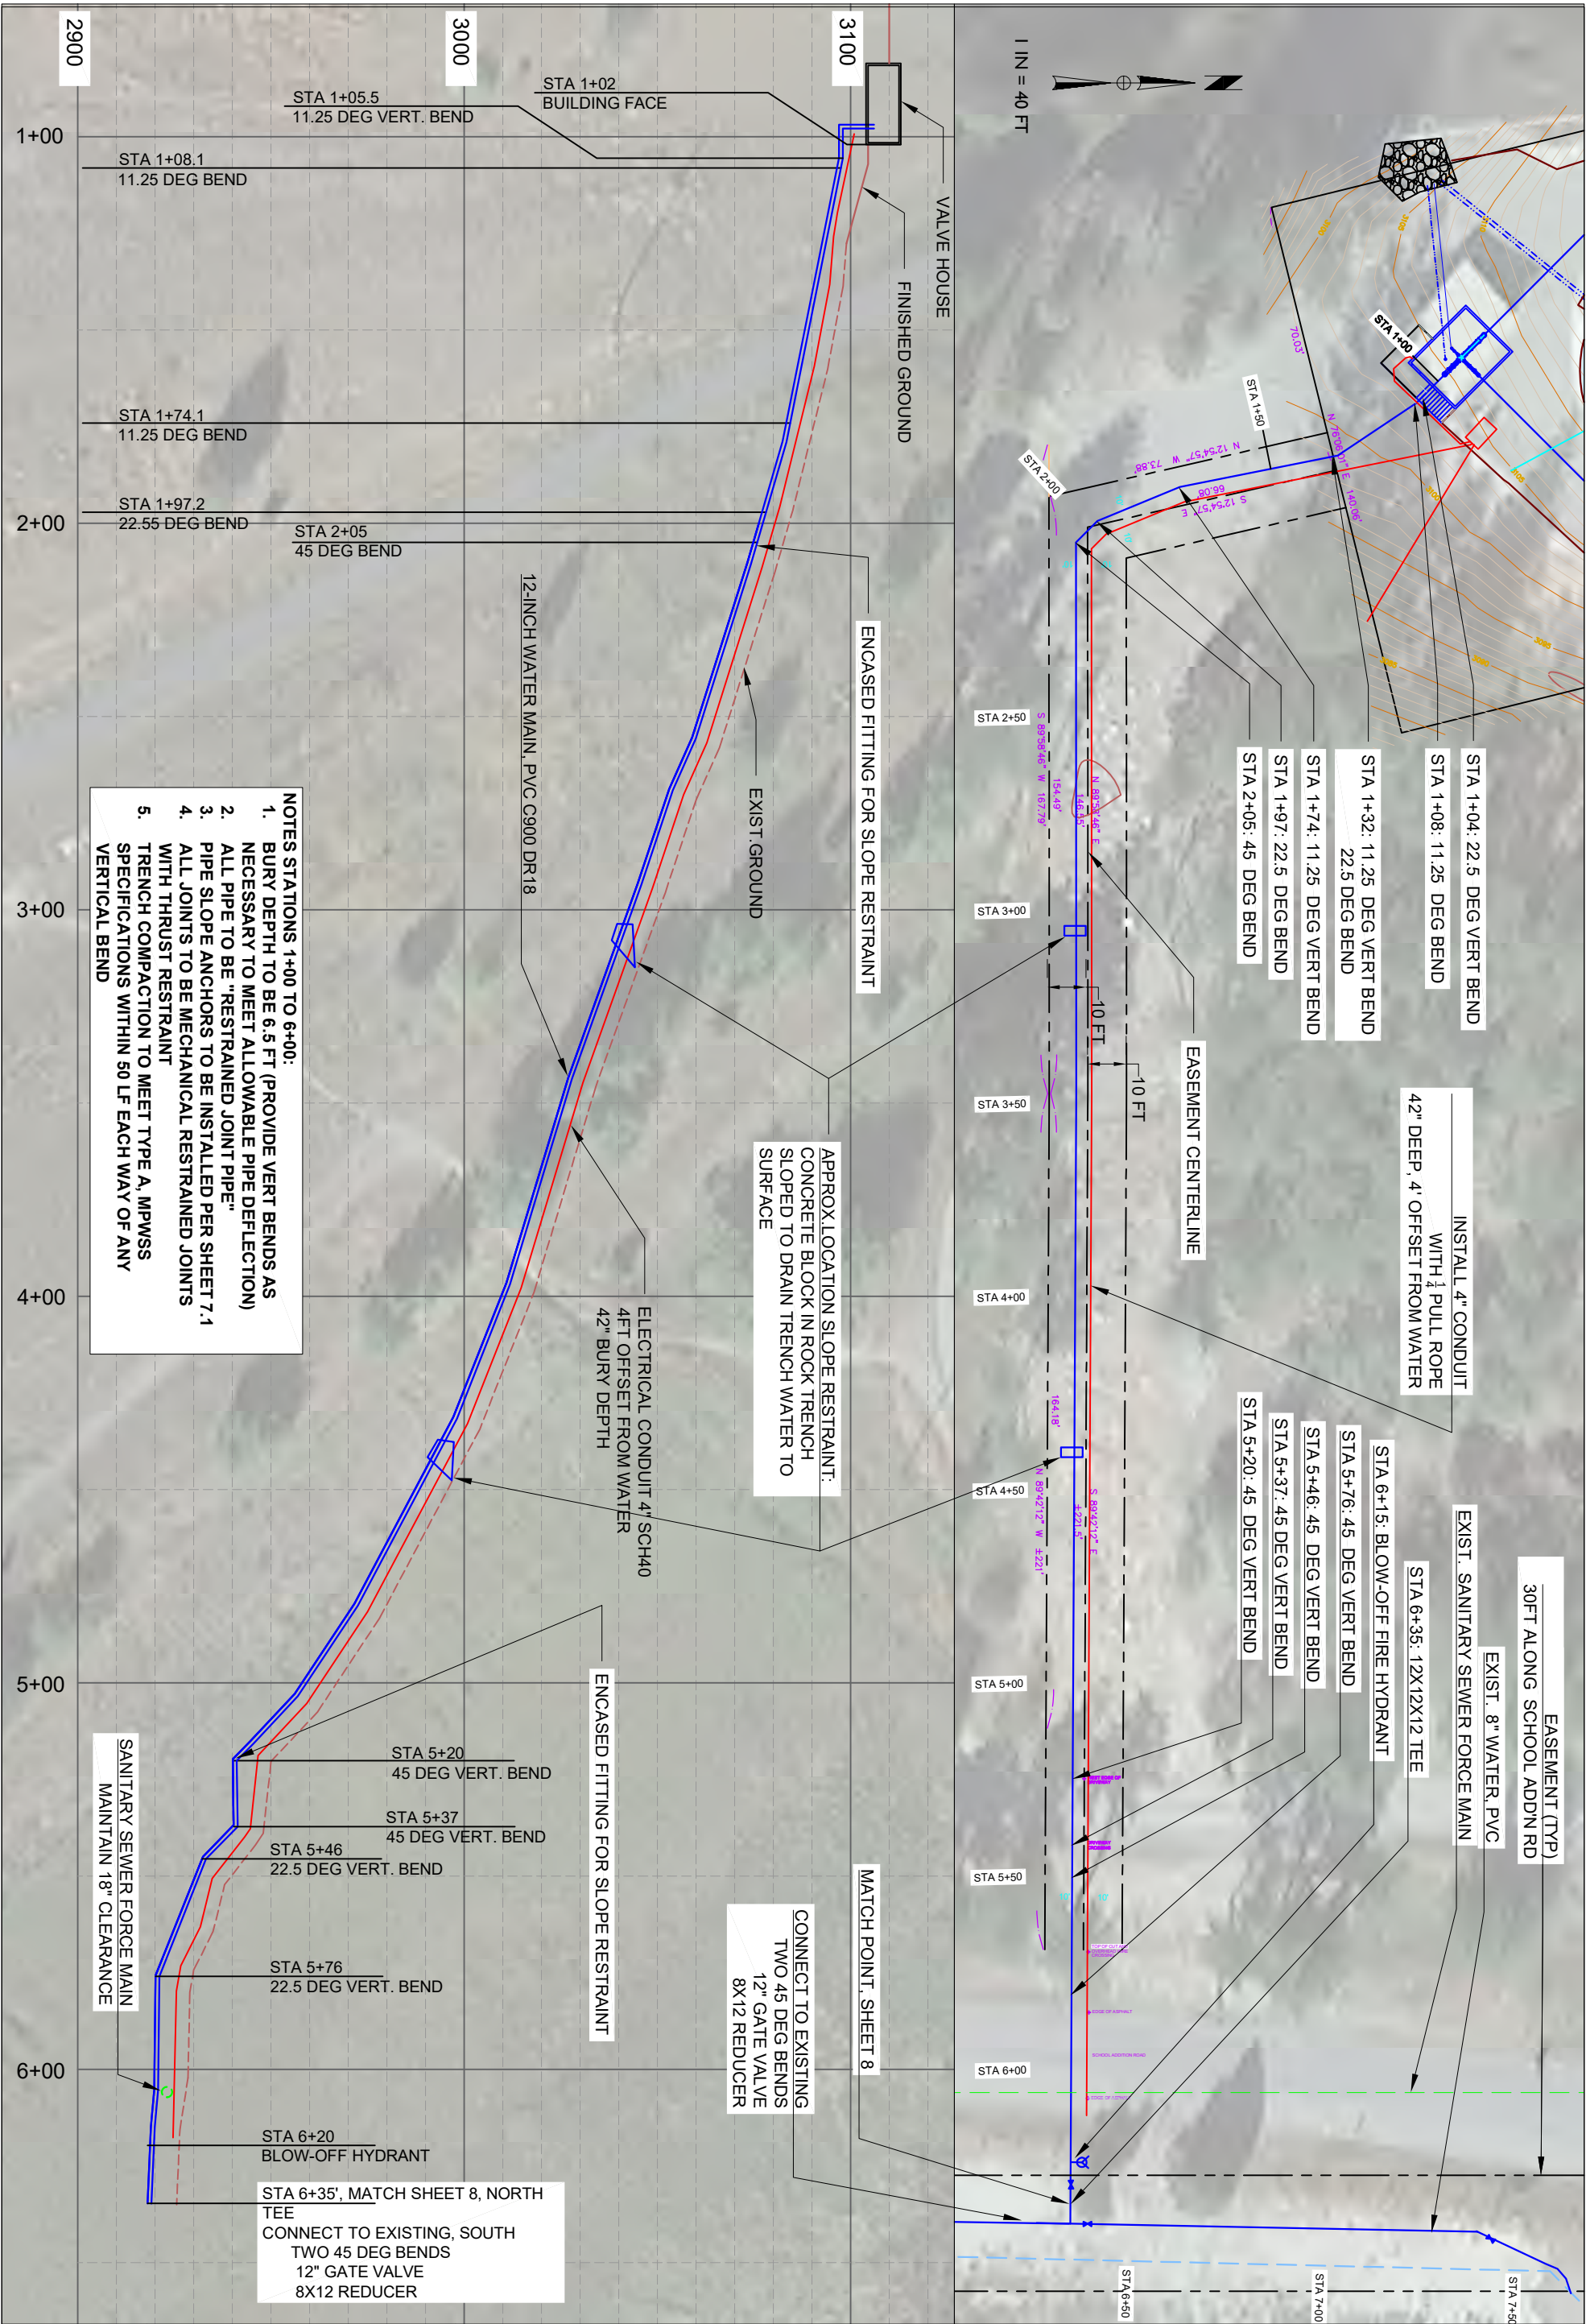

- NOTES STATIONS 1+00 TO 6+00:
- BURY DEPTH TO BE 6.5 FT (PROVIDE VERT BENDS AS NECESSARY TO MEET ALLOWABLE PIPE DEFLECTION)
 - ALL PIPE TO BE "RESTRAINED JOINT PIPE"
 - PIPE SLOPE ANCHORS TO BE INSTALLED PER SHEET 7.1
 - ALL JOINTS TO BE MECHANICAL RESTRAINED JOINTS
 - TRENCH COMPACTION TO MEET TYPE A, MPWSS SPECIFICATIONS WITHIN 50 LF EACH WAY OF ANY VERTICAL BEND

SHARI A JOHNSON &
ASSOCIATES ENGINEERING
PLLC

Engineering@SAJmontana.com
406-261-3019

SOMERS NEW WATER TANK IMPROVEMENTS
SOMERS WATER & SEWER DISTRICT, MONTANA

TRANSMISSION MAIN



Date
Designed SAJ 2/11/20
Revisions SAJ 11/7/20 ASBUILT 3/30/23

SURVEY PREPARED BY:
WILLIAM BRECKENRIDGE, PLS

Sheet Number:

7

of 10

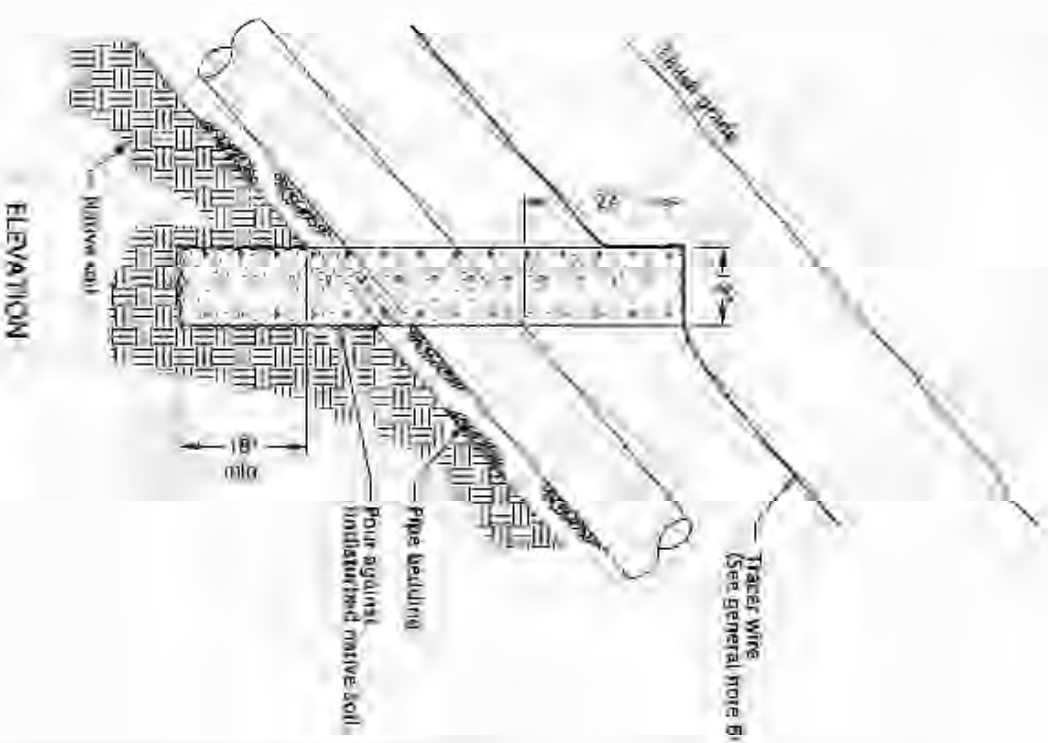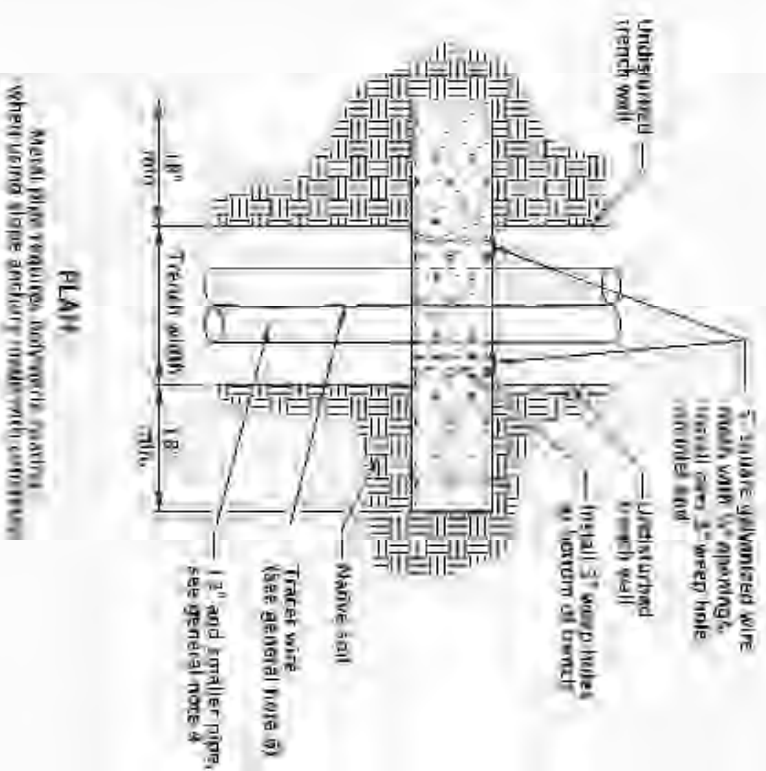

<p>GENERAL NOTES FOR ALL DETAILS:</p> <ol style="list-style-type: none"> Concrete pipe sections shall be constructed using forms whose joints, storm drains and other pipe joints are constructed with a slope 2:1 or greater. Remove forms prior to backfilling trench. All concrete shall be compacted to finish surface. Conduit to enter from a trench or ground above anchors shall be: <table border="1"> <tr> <td>6.0 IN.</td> <td>SPACING (on center)</td> </tr> <tr> <td>6.0-12.0</td> <td>12"</td> </tr> <tr> <td>12.0-15.0</td> <td>15"</td> </tr> <tr> <td>15.0-18"</td> <td>15" or concrete encasement</td> </tr> </table> Dimensions for embedment for above entry shall 12" shall be approved by the engineer. See SDG DWG 1000 for the pipe installation details. See SDG DWG 1000 for detail with utility inventory required. 		6.0 IN.	SPACING (on center)	6.0-12.0	12"	12.0-15.0	15"	15.0-18"	15" or concrete encasement
6.0 IN.	SPACING (on center)								
6.0-12.0	12"								
12.0-15.0	15"								
15.0-18"	15" or concrete encasement								
CAC sheet no. <u> </u>	SHA <u> </u>								
<p>MANHOLE REPORT DATE: <u>12/24/2015</u></p> <p>NOTE: <u>Actual and proposed shall be in accordance with the current Oregon Department of Transportation</u></p>									
<p>OREGON STANDARD DRAWINGS:</p> <p>PIPE SLOPE ANCHORS- CONCRETE</p>									
DATE: <u> </u>	3018								
<p>NUMBER DESCRIBED: <u> </u></p>									



ABOVE: RESTRAINED PIPE LEAVING VALVE HOUSE




LEFT: TRANSMISSION MAIN LOOKING EAST



CONCRETE SLOPE RESTRAINT (TYP)

of 10	7.2	Sheet Number:	SHARI A JOHNSON & ASSOCIATES ENGINEERING PLLC	SOMERS NEW WATER TANK IMPROVEMENTS SOMERS WATER & SEWER DISTRICT, MONTANA	Date Designed <u>SAJ</u> 2/11/20 Revisions <u>SAJ 11/7/20</u> ASBUILT 3/30/23
			Engineering@SAJmontana.com 406-261-3019	RESTRAINTS - TRANSMISSION MAIN (SEE PHOTO FILE)	SURVEY PREPARED BY: WILLIAM BRECKENRIDGE, PLS

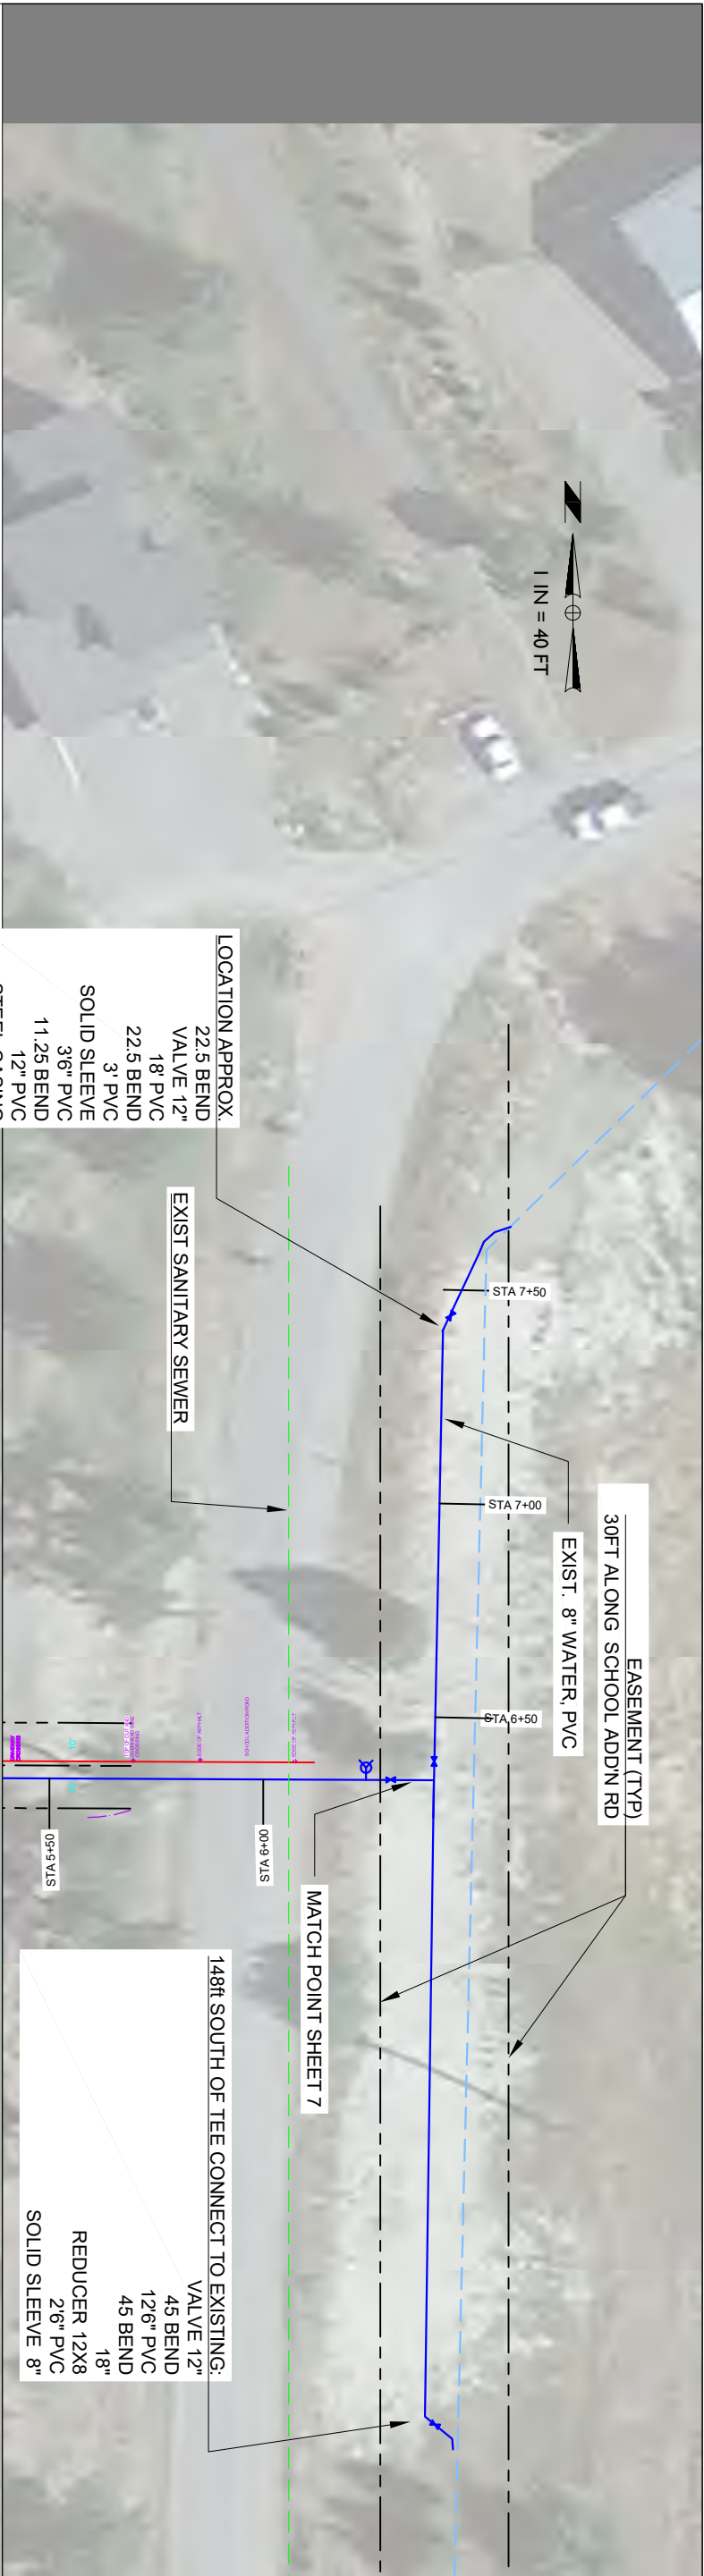

LOCATION APPROX.
22.5 BEND
VALVE 12"
18" PVC
22.5 BEND
3" PVC
SOLID SLEEVE
36" PVC
11.25 BEND
12" PVC
STEEL CASING


EXIST SANITARY SEWER

EASEMENT (TYP)
30FT ALONG SCHOOL ADDN RD
EXIST. 8" WATER, PVC

MATCH POINT SHEET 7

148ft SOUTH OF TEE CONNECT TO EXISTING:
VALVE 12"
45 BEND
126" PVC
45 BEND
18"
REDUCER 12X8
26" PVC
SOLID SLEEVE 8"

1. NOTE: EXISTING PIPE TYPE, LOCATION, AND SIZE APPROXIMATE. CONTRACTOR TO FIELD VERIFY
2. ASBUILT: SEE PLAN VIEW FOR CONNECTION NOTES

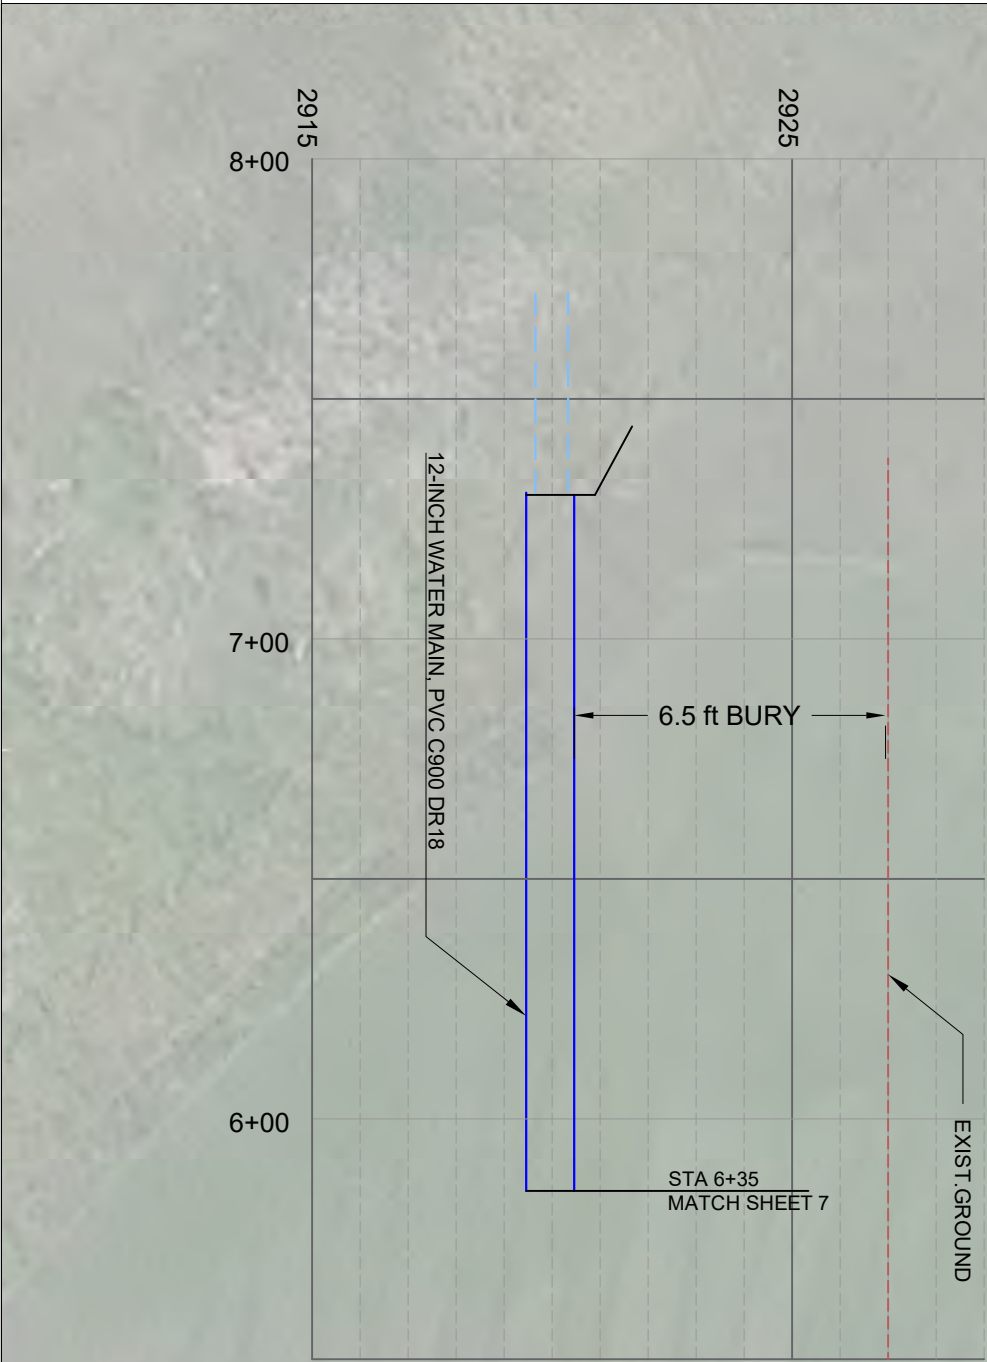



ABOVE:TANK MAIN CROSSING
SCHOOL ADDITION ROAD





LEFT:HYDRANT ON TANK MAIN
TEE TO CONNECT TO
MAIN LINE (LOOKING
WEST)



CONNECTION NORTH END

CONNECTION SOUTH END

8.1	Sheet Number:	SHARI A JOHNSON & ASSOCIATES ENGINEERING PLLC	SOMERS NEW WATER TANK IMPROVEMENTS SOMERS WATER & SEWER DISTRICT, MONTANA	Date Designed <u>SAJ</u> 2/11/20	
		Engineering@SAJmontana.com 406-261-3019		Revisions <u>SAJ 11/7/20</u> ASBUILT 3/30/23	
			SCHOOL ADDITION RD CONNECTIONS	SURVEY PREPARED BY: WILLIAM BRECKENRIDGE, PLS	

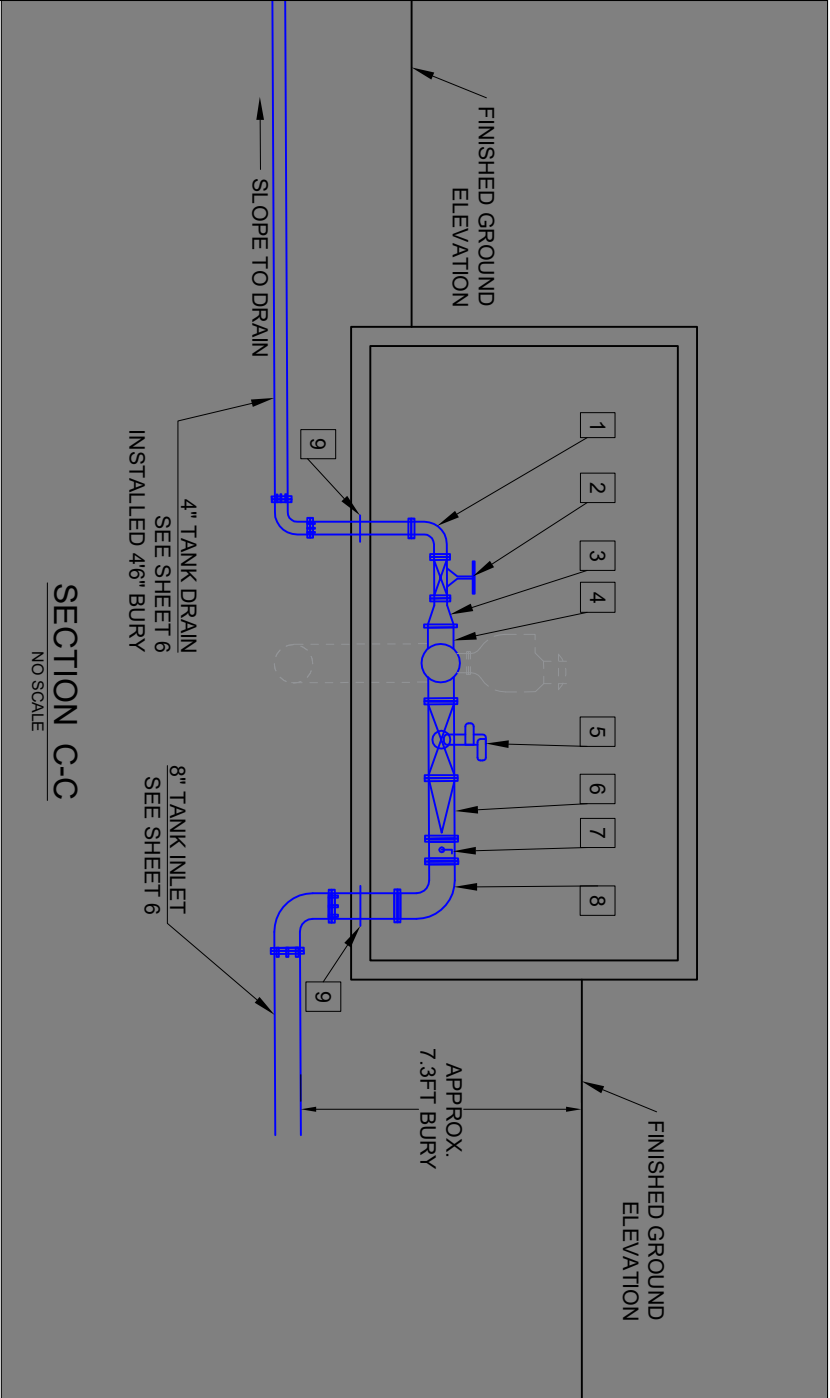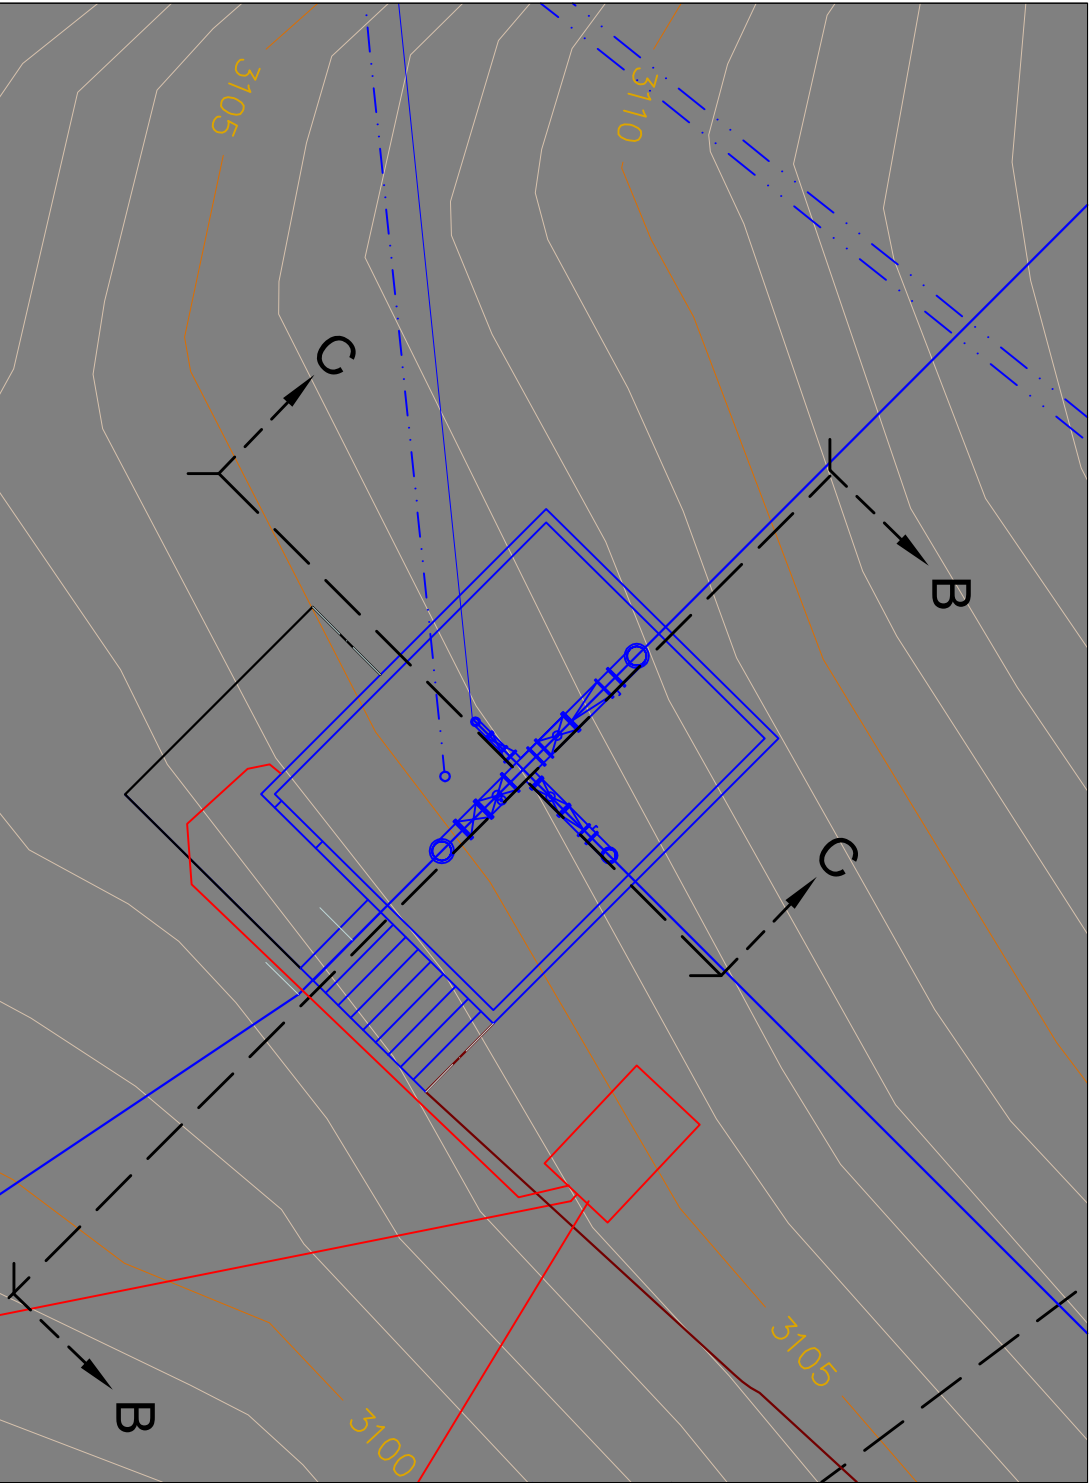

SECTION C-C

NO SCALE

NOTES SECTION C-C:


1. 4" 90 DEG ELBOW
2. 4" GATE VALVE (NORMALLY CLOSED)
3. 8X4 REDUCER
4. 12X8 CROSS-
5. 8" CLASS 150, MOTOR ACTUATED BALL VALVE, VAL-MATIC SERIES 4000 OR EQUIVALENT

6. 8" CHECK VALVE
7. SMOOTH NOSE SAMPLING TAP
8. 8" 90 DEG ELBOW
9. 10 PIPE PENETRATION PIPE FLANGE

NOTES SECTION B-B:

10. 12" 90 DEG ELBOW
11. SMOOTH NOSE SAMPLING TAP
12. 12" CHECK VALVE
13. 12"CLASS 150, MOTOR ACTUATED BALL VALVE, VAL-MATIC SERIES 4000 OR EQUIVALENT
14. 12X6 CROSS
15. 6" CLASS 150, DEZURIK AIR/VAC RELEASE, SINGLE BODY MODEL 150C OR EQUIVALENT. PROVIDE DOWNWARD FACING, SCREENED RELIEF PIPE PER DEQ-1, 8.5.2.

16. 12" GATE VALVE
17. 12" 90 DEG ELBOW

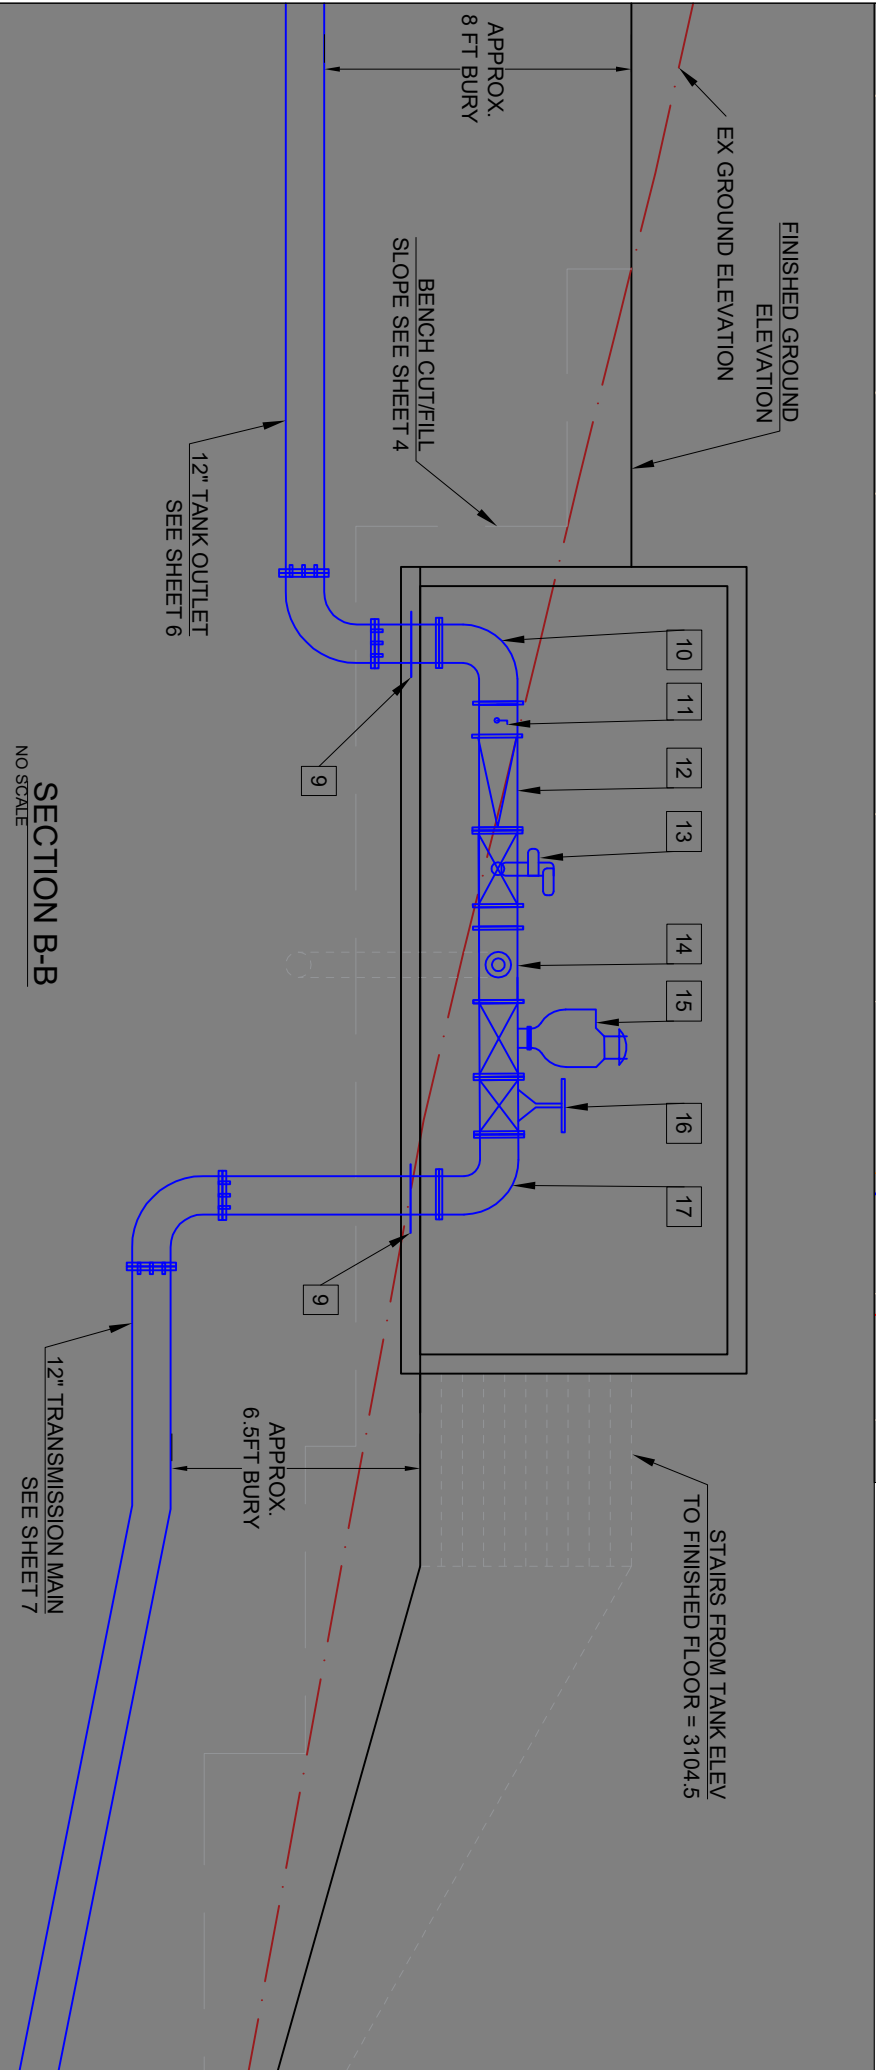

SECTION B-B

NO SCALE

SOMERS NEW WATER TANK IMPROVEMENTS
SOMERS WATER & SEWER DISTRICT, MONTANA


VALVE HOUSE - NEW TANK SITE

Date 2/11/20
Designed SAJ
Revisions SAJ 11/7/20 ASBUILT 3/30/23

SURVEY PREPARED BY:
WILLIAM BRECKENRIDGE, PLS

SHARI A JOHNSON &
ASSOCIATES ENGINEERING
PLLC
Engineering@SAJmontana.com
406-261-3019


Sheet Number:

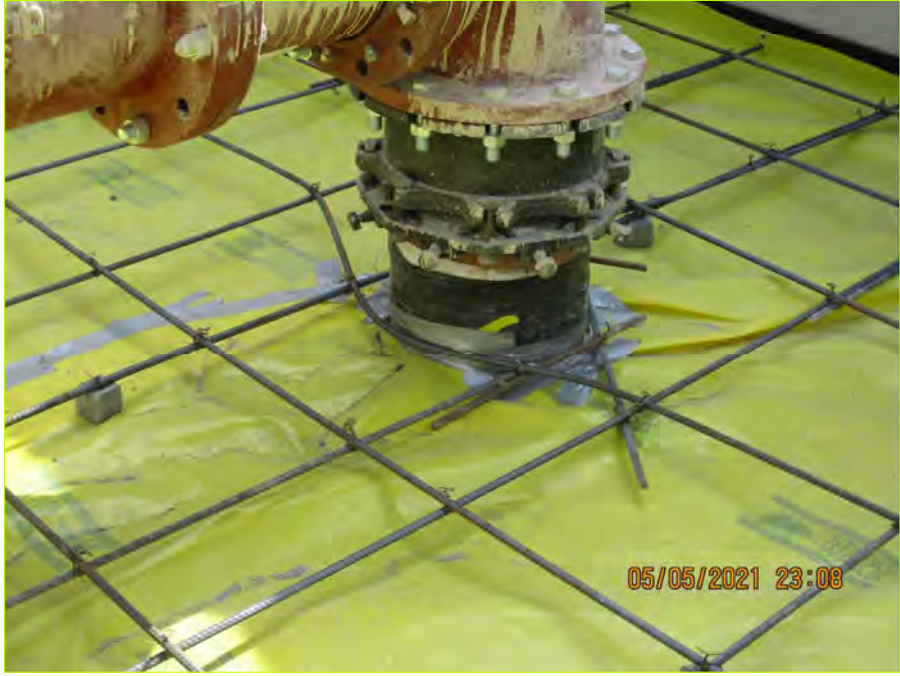



VALVE HOUSE PIPE PENETRATIONS



VALVE HOUSE FOUNDATION DRAIN

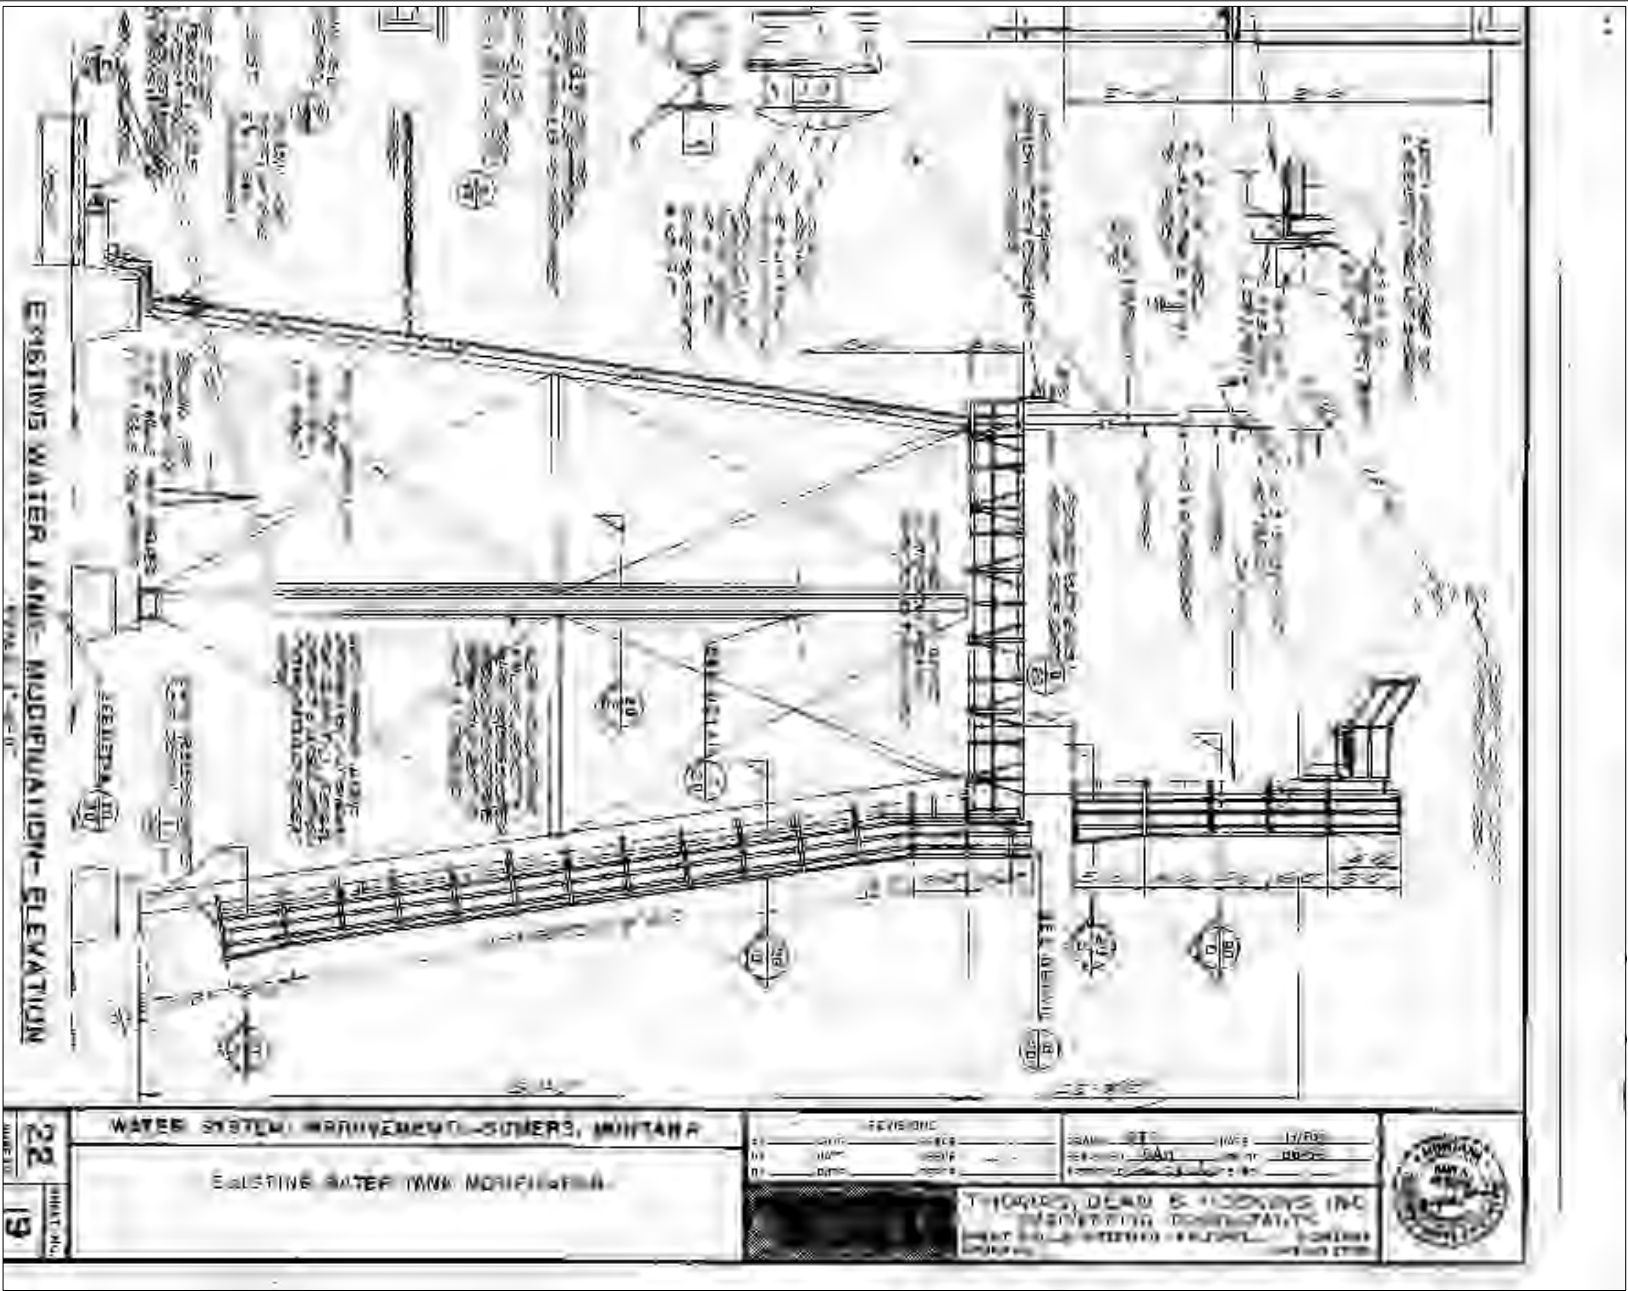

EXISTING
TANK
RECORD
DRAWINGS
(no scale)

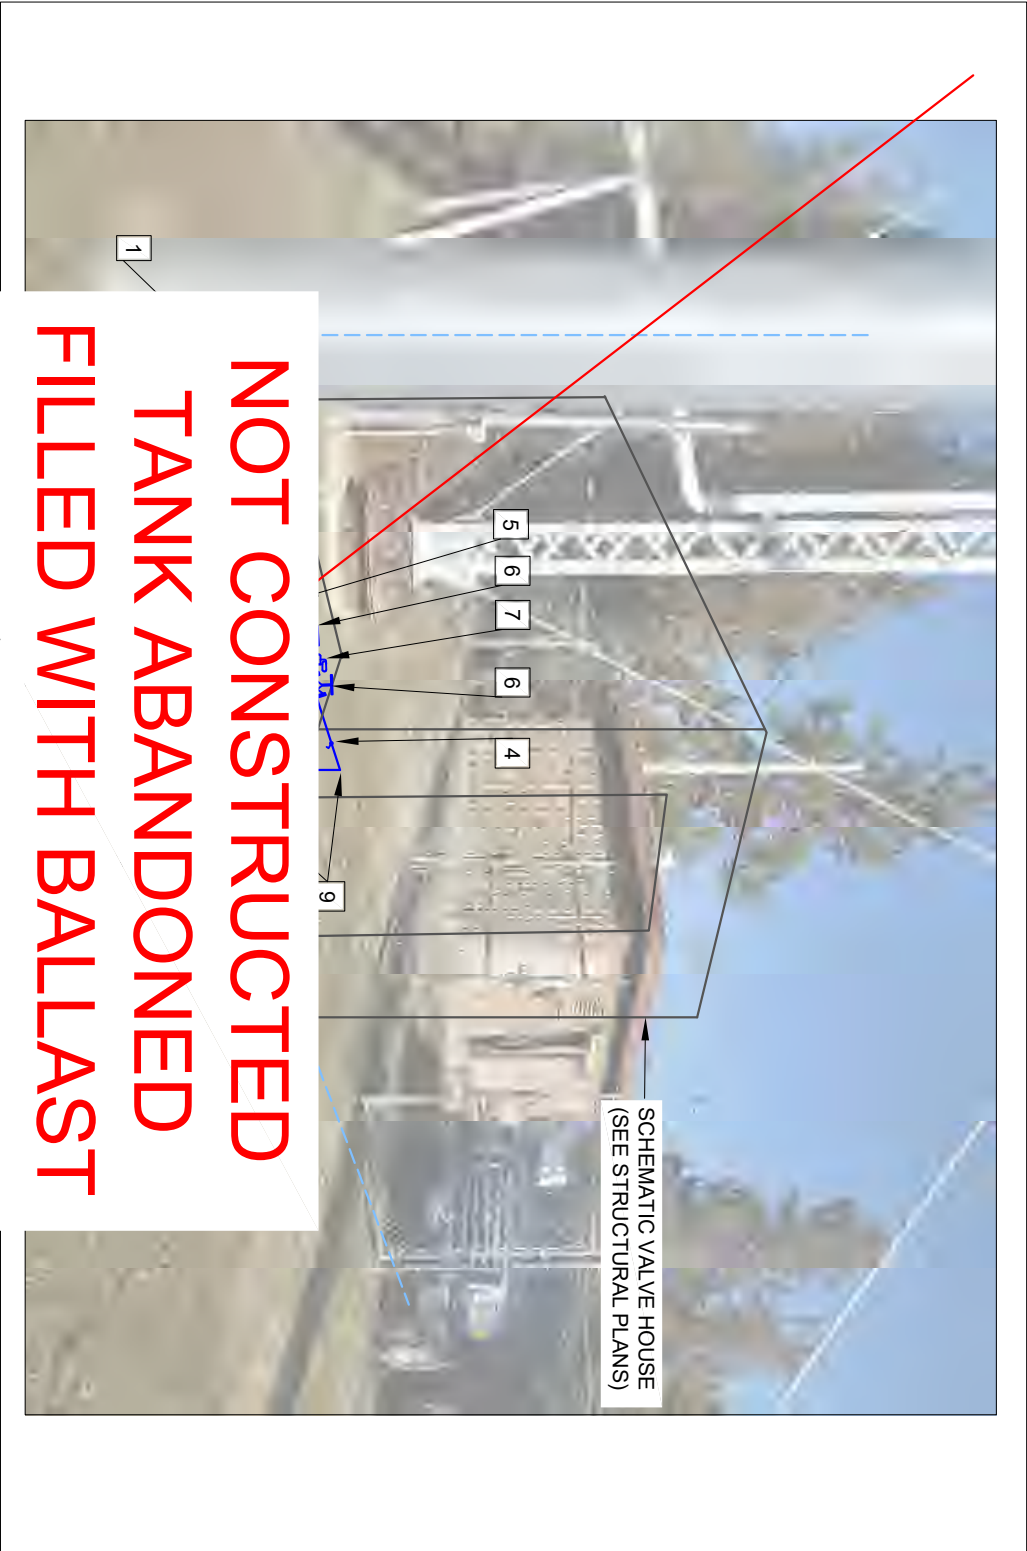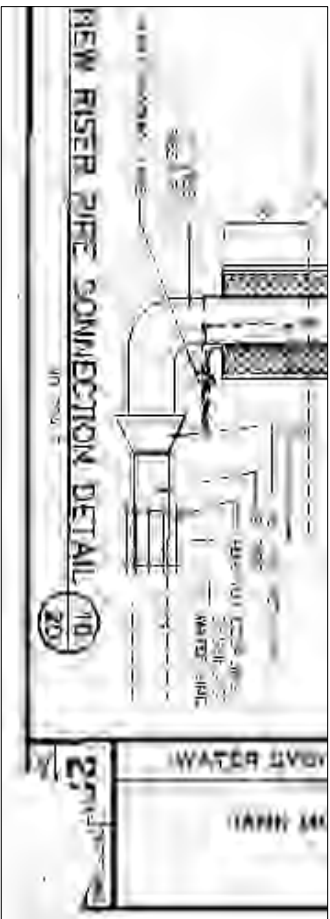

NOT CONSTRUCTED
TANK ABANDONED
FILLED WITH BALLAST
PER STRUCTURAL
EVALUATION

1. 10" SUPPORTED 90 DEG ELBOW INCLUDING CONCRETE PAD OR OTHER FOUNDATION SUPPORT AS RECOMMENDED BY MANUFACTURER.
2. RE-INSULATE EXPOSED PIPE & FITTINGS WITH EXISTING HEAT TAPE SYSTEM
3. RE-ESTABLISH HEAT TAPE PROTECTION ON NEW & EXISTING EXPOSED PIPES
4. SMOOTH NOSE SAMPLING TAP
5. 10x8 REDUCER
6. 8" GATE VALVES (TWO)
7. 8" CLASS 150, MOTOR ACTUATED BALL VALVE, VAL-MATIC SERIES 4000 OR EQUIVALENT
8. BUILDING FLOORWALL PENETRATION
9. 8" 90 DEG ELBOWS (TWO)
10. CONNECT TO EXISTING 8" WATER LINE (VERIFY PIPE SIZE, LOCATION & TYPE)
11. DI PIPE & MECHANICAL JOINTS (MEGA LUG OR EQUAL) REQUIRED ON ALL PIPE UNDER & WITHIN 10 FEET OF BUILDING OR TANK FACES

Date
Designed _SAJ_ 2/11/20
Revisions _SAJ 11/7/20 ASBUILT 3/30/23
SURVEY PREPARED BY:
WILLIAM BRECKENRIDGE, PLS

SOMERS NEW WATER TANK IMPROVEMENTS
SOMERS WATER & SEWER DISTRICT, MONTANA

EXISTING TANK VALVE HOUSE

SHARI A JOHNSON &
ASSOCIATES ENGINEERING
PLLC
Engineering@SAJmontana.com
406-261-3019

Appendix H: Audited Financial Statement



SOMERS WATER & SEWER DISTRICT, MONTANA

AUDITED FINANCIAL STATEMENTS

June 30, 2021



**SOMERS WATER & SEWER DISTRICT, MONTANA
CONTENTS**

AUDITED FINANCIAL STATEMENTS	<u>Page</u>
Organization	3
Independent auditors' report	4-5
Statement of net position - proprietary funds	6
Statement of revenues, expenses, and changes in fund net position - proprietary funds	7
Statement of cash flows - proprietary fund types	8
Statement of net position - fiduciary funds	9
Notes to the financial statements	10-26
 REQUIRED SUPPLEMENTARY INFORMATION	
Schedule of proportionate share of the net pension liability	28
Schedule of contributions	29
Notes to the required supplementary information	30-31
 SUPPLEMENTARY INFORMATION	
Independent auditors' report on internal control over financial reporting and on compliance and other matters based on an audit of financial statements performed in accordance with <i>Government Auditing Standards</i>	33-34
Schedule of findings and responses	35-40

SOMERS WATER & SEWER DISTRICT, MONTANA
ORGANIZATION
June 30, 2021

DISTRICT TRUSTEES

Jonathan Fetter-Vorm	President
Bob Foley	Trustee
Margery Fox	Trustee
Duane Howell	Trustee
Karen Rhodes	Trustee

DISTRICT OFFICIALS

Andy Loudermilk	Manager/Operator
Kerah Harmon	Secretary



JCCS

ACCOUNTING
AUDIT
TAX
EMPLOYEE BENEFITS
SPECIALIZED SERVICES

**To the District Trustees
Somers County Water & Sewer District, Montana**

INDEPENDENT AUDITORS' REPORT

Report on the Financial Statements

We have audited the accompanying financial statements of the business-type activities, each major fund, and the aggregate remaining fund information of the Somers County Water & Sewer District, as of and for the year ended June 30, 2021, and the related notes to the financial statements, which collectively comprise the District's basic financial statements as listed in the table of contents.

Management's Responsibility for the Financial Statements

Management is responsible for the preparation and fair presentation of these financial statements in accordance with accounting principles generally accepted in the United States of America; this includes the design, implementation, and maintenance of internal control relevant to the preparation and fair presentation of financial statements that are free from material misstatement, whether due to fraud or error.

Auditors' Responsibility

Our responsibility is to express an opinion on these financial statements based on our audit. We conducted our audit in accordance with auditing standards generally accepted in the United States of America and the standards applicable to the financial audits contained in *Government Auditing Standards*, issued by the Comptroller General of the United States. Those standards require that we plan and perform the audit to obtain reasonable assurance about whether the financial statements are free from material misstatement.

An audit involves performing procedures to obtain audit evidence about the amounts and disclosures in the financial statements. The procedures selected depend on the auditor's judgment, including the assessment of the risks of material misstatement of the financial statements, whether due to fraud or error. In making those risk assessments, the auditor considers internal control relevant to the entity's preparation and fair presentation of the financial statements in order to design audit procedures that are appropriate in the circumstances, but not for the purpose of expressing an opinion on the effectiveness of the entity's internal control. Accordingly, we express no such opinion. An audit also includes evaluating the appropriateness of accounting policies used and the reasonableness of significant accounting estimates made by management, as well as evaluating the overall presentation of the financial statements.

We believe that the audit evidence we have obtained is sufficient and appropriate to provide a basis for our audit opinions.

Opinions

In our opinion the financial statements referred to above present fairly, in all material respects, the respective financial position of the business-type activities, each major fund, and the aggregate remaining fund information of the Somers County Water & Sewer District, as of June 30, 2021, and the respective changes in financial position and, where applicable, cash flows thereof for the year then ended in accordance with accounting principles generally accepted in the United States of America.

Other Matters

Required Supplementary Information

Accounting principles generally accepted in the United States of America require that the schedules of proportionate share of the net pension liability, and the schedules of contributions and the related notes on pages 28 through 31 be presented to supplement the basic financial statements. Such information, although not a part of the basic financial statements, is required by the Government Accounting Standards Board, who considers it to be an essential part of financial reporting for placing the basic financial statements in an appropriate operational, economic, or historical context. We have applied certain limited procedures to the required supplementary information in accordance with auditing standards generally accepted in the United States of America, which consisted of inquiries of management about the methods of preparing the information and comparing the information for consistency with management's responses to our inquiries, the basic financial statements, and other knowledge we obtained during our audit of the basic financial statements. We do not express an opinion or provide any assurance on the information because the limited procedures do not provide us with sufficient evidence to express an opinion or provide any assurance.

Management has omitted the Management Discussion and Analysis that accounting principles generally accepted in the United States of America require to be presented to supplement the basic financial statements. Such missing information, although not a part of the basic financial statements, is required by the Governmental Accounting Standards Board, who considers it to be an essential part of financial reporting for placing the basic financial statements in an appropriate operational, economic, or historical context. Our opinion on the basic financial statements is not affected by this missing information.

Other Reporting Required by Government Auditing Standards

In accordance with *Government Auditing Standards*, we have also issued our report dated May 27, 2022, on our consideration of the Somers County Water & Sewer District's internal control over financial reporting and on our tests of its compliance with certain provisions of laws, regulations, contracts, and grant agreements and other matters. The purpose of that report is to describe the scope of our testing of internal control over financial reporting and compliance and the results of that testing, and not to provide an opinion on the internal control over financial reporting or on compliance. That report is an integral part of an audit performed in accordance with *Government Auditing Standards* in considering the Somers County Water & Sewer District's internal control over financial reporting and compliance.

Junkermier, Clark, Campanella, Stevens, P.C.

Great Falls, Montana
May 27, 2022

SOMERS WATER & SEWER DISTRICT, MONTANA
STATEMENT OF NET POSITION - PROPRIETARY FUNDS
June 30, 2021

	<u>Water</u>	<u>Sewer</u>	<u>Total</u>
ASSETS			
Current assets			
Cash and cash equivalents	\$ 181,352	\$ 731,349	\$ 912,701
Restricted cash and cash equivalents	20,618	-	20,618
Accounts receivable, net	19,115	18,232	37,347
Advance to other funds - current	-	10,444	10,444
Due from other governments	<u>616,741</u>	<u>-</u>	<u>616,741</u>
	<u>837,826</u>	<u>760,025</u>	<u>1,597,851</u>
Noncurrent assets			
Advances to other funds	-	192,494	192,494
Capital assets - land	146,058	-	146,058
Capital assets - construction in progress	1,620,075	-	1,620,075
Capital assets - depreciable, net	<u>1,017,999</u>	<u>1,071,071</u>	<u>2,089,070</u>
	<u>2,784,132</u>	<u>1,263,565</u>	<u>4,047,697</u>
Total assets	<u>3,621,958</u>	<u>2,023,590</u>	<u>5,645,548</u>
Deferred outflows of resources			
Pension	15,516	15,516	31,032
Total assets and deferred outflows of resources	<u>\$ 3,637,474</u>	<u>\$ 2,039,106</u>	<u>\$ 5,676,580</u>
LIABILITIES			
Current liabilities			
Accounts payable	\$ 616,741	\$ -	\$ 616,741
Accrued payroll	760	1,898	2,658
Refunds payable	173	5	178
Advances payable - current	10,444	-	10,444
Due to other governments	-	3	3
Current portion of long-term capital liabilities	<u>540,000</u>	<u>-</u>	<u>540,000</u>
Total current liabilities	<u>1,168,118</u>	<u>1,906</u>	<u>1,170,024</u>
Noncurrent liabilities			
Advances payable	192,494	-	192,494
Noncurrent portion of long-term capital liabilities	1,081,693	-	1,081,693
Net pension liability	<u>18,868</u>	<u>18,869</u>	<u>37,737</u>
	<u>1,293,055</u>	<u>18,869</u>	<u>1,311,924</u>
Total liabilities	<u>2,461,173</u>	<u>20,775</u>	<u>2,481,948</u>
Deferred inflows of resources			
Pension	<u>540</u>	<u>540</u>	<u>1,080</u>
NET POSITION			
Net investment in capital assets	1,162,439	1,071,071	2,233,510
Restricted for debt covent	20,618	-	20,618
Unrestricted	<u>(7,296)</u>	<u>946,720</u>	<u>939,424</u>
Total net position	<u>1,175,761</u>	<u>2,017,791</u>	<u>3,193,552</u>
Total liabilities, deferred inflows, and net position	<u>\$ 3,637,474</u>	<u>\$ 2,039,106</u>	<u>\$ 5,676,580</u>

See notes to financial statements.

SOMERS WATER & SEWER DISTRICT, MONTANA
STATEMENT OF REVENUES, EXPENSES, AND CHANGE IN FUND NET POSITION -
PROPRIETARY FUNDS
June 30, 2021

	<u>Water</u>	<u>Sewer</u>	<u>Total</u>
Operating revenues			
Charges for services	\$ 182,156	\$ 274,446	\$ 456,602
Miscellaneous revenue	<u>22,050</u>	<u>453</u>	<u>22,503</u>
	<u>204,206</u>	<u>274,899</u>	<u>479,105</u>
Operating expenses			
Personal services	64,818	64,809	129,627
Supplies	20,275	14,383	34,658
Purchased services	38,574	97,235	135,809
Fixed charges	3,546	3,126	6,672
Depreciation	<u>57,969</u>	<u>68,423</u>	<u>126,392</u>
	<u>185,182</u>	<u>247,976</u>	<u>433,158</u>
Operating income	<u>19,024</u>	<u>26,923</u>	<u>45,947</u>
Non-operating revenues (expenses)			
Intergovernmental	1,051	1,051	2,102
Investment	1,107	4,236	5,343
Debt service interest expense	<u>(4,023)</u>	<u>(20)</u>	<u>(4,043)</u>
	<u>(1,865)</u>	<u>5,267</u>	<u>3,402</u>
Change in net position	<u>17,159</u>	<u>32,190</u>	<u>49,349</u>
Net position - beginning of year	1,226,478	2,017,072	3,243,550
Restatements	<u>(67,876)</u>	<u>(31,471)</u>	<u>(99,347)</u>
Net position - beginning of year - restated	<u>1,158,602</u>	<u>1,985,601</u>	<u>3,144,203</u>
Net position - end of year	<u>\$ 1,175,761</u>	<u>\$ 2,017,791</u>	<u>\$ 3,193,552</u>

See notes to financial statements.